

	1	2	3	4	5	6	7	8	9	10																																																	
A											A																																																
B											B																																																
C											C																																																
D											D																																																
The technical information contained in this document is the exclusive property of Schneider Electric Industries S.A.S. and cannot be used or disclosed to third parties or any kind without its written consent. Only those drawings and documents which are specifically intended for the use of the recipient are in open position of view out with the operating mechanism and are not to be used for any other purpose. Les informations techniques sont la propriété exclusive de Schneider Electric Industries S.A.S. et ne peuvent être utilisées ou divulguées à des tiers sans son accord écrit. Seuls les documents et plans qui sont destinés à l'usage du destinataire sont en position ouverte et ne doivent pas être utilisés à d'autres fins.																																																											
<table><tr><td>01</td><td>07062011</td><td>Tel que construit / As built</td><td>DE FREITAS</td><td>CERCIAT</td><td>GUILLET</td><td></td><td></td><td></td><td></td><td></td><td></td></tr><tr><td>00</td><td>28022011</td><td>Edition originale / First issue</td><td>PEYRON</td><td>GUILLET</td><td>GUILLET</td><td></td><td></td><td></td><td></td><td></td><td></td></tr><tr><td>Ind</td><td>Date</td><td>Modification / Modification</td><td>Nom / Name</td><td>Visa</td><td>Nom / Name</td><td>Visa</td><td>Nom / Name</td><td>Visa</td><td>Archiv. / Micro-filmed</td><td></td><td></td></tr><tr><td>Rev</td><td>Date</td><td></td><td>Dessine / Drawn</td><td>Verifie / Checked</td><td>Approuve / Approved</td><td></td><td></td><td></td><td></td><td></td><td></td></tr></table>												01	07062011	Tel que construit / As built	DE FREITAS	CERCIAT	GUILLET							00	28022011	Edition originale / First issue	PEYRON	GUILLET	GUILLET							Ind	Date	Modification / Modification	Nom / Name	Visa	Nom / Name	Visa	Nom / Name	Visa	Archiv. / Micro-filmed			Rev	Date		Dessine / Drawn	Verifie / Checked	Approuve / Approved						
01	07062011	Tel que construit / As built	DE FREITAS	CERCIAT	GUILLET																																																						
00	28022011	Edition originale / First issue	PEYRON	GUILLET	GUILLET																																																						
Ind	Date	Modification / Modification	Nom / Name	Visa	Nom / Name	Visa	Nom / Name	Visa	Archiv. / Micro-filmed																																																		
Rev	Date		Dessine / Drawn	Verifie / Checked	Approuve / Approved																																																						
<table><tr><td colspan="6">ARMOIRES MONITORING PTR SCHEMA / MONITORING CUBICLES PTR DIAGRAM</td><td colspan="6">MONITORING PHOTOVOLTAIQUE / PHOTOVOLTAIC MONITORING CASINO LOT 4 PESSAC-RODEZ-ARLES</td></tr><tr><td colspan="2">Echelle / Scale 1/1</td><td colspan="2"></td><td colspan="6" rowspan="2"></td></tr><tr><td colspan="4">Unité / Department P&EC</td></tr><tr><td colspan="2">Code d'identification / Distribution code</td><td colspan="2">Projet - No commande / Project Order No. FPVTB0540</td><td colspan="4">02985574</td><td colspan="2">Indice / Rev 01</td><td colspan="2">Folio / Sheet 001</td></tr></table>												ARMOIRES MONITORING PTR SCHEMA / MONITORING CUBICLES PTR DIAGRAM						MONITORING PHOTOVOLTAIQUE / PHOTOVOLTAIC MONITORING CASINO LOT 4 PESSAC-RODEZ-ARLES						Echelle / Scale 1/1										Unité / Department P&EC				Code d'identification / Distribution code		Projet - No commande / Project Order No. FPVTB0540		02985574				Indice / Rev 01		Folio / Sheet 001											
ARMOIRES MONITORING PTR SCHEMA / MONITORING CUBICLES PTR DIAGRAM						MONITORING PHOTOVOLTAIQUE / PHOTOVOLTAIC MONITORING CASINO LOT 4 PESSAC-RODEZ-ARLES																																																					
Echelle / Scale 1/1																																																											
Unité / Department P&EC																																																											
Code d'identification / Distribution code		Projet - No commande / Project Order No. FPVTB0540		02985574				Indice / Rev 01		Folio / Sheet 001																																																	

		1	2	3	4	5	6	7	8	9				10			
A	The technical information contained in this document is the exclusive property of Schneider Electric Industries S.A.S. and cannot be used or disclosed to third parties without the written consent of Schneider Electric Industries S.A.S. The information contained in this document is for reference only and does not constitute a contract. The user must refer to the original document for the complete information. The user must refer to the original document for the complete information. The user must refer to the original document for the complete information.	Folio Sheet	Designation Designation	Indice de modification Revision													
		001	PAGE DE GARDE / FRONT PAGE	00	01												
		002	PAGE RECAPITULATIVE / SUMMARY	00	01												
		010	LISTE DES SYMBOLES / SCHEDULE OF SYMBOLS	00													
		011	LISTE DES SYMBOLES / SCHEDULE OF SYMBOLS	00													
		012	PRINCIPE DE REPERAGE / PRINCIPLE OF MARKING	00													
		013	REPERES ESSENTIELS - TABLE 1 - / HIGHER-LEVEL DESIGNATION - TABLE 1 -	00													
		014	REPERAGE EMPLACEMENTS PHYSIQUES - TABLE 2 - / LOCATIONS OF ITEMS - TABLE 2 -	00													
		015	REPERAGE DES MATERIELS - TABLE 3 - / IDENTIFICATION ITEMS - TABLE 3 -	00													
		019	MARQUAGE / NAME PLATE	00	01												
B	The technical information contained in this document is the exclusive property of Schneider Electric Industries S.A.S. and cannot be used or disclosed to third parties without the written consent of Schneider Electric Industries S.A.S. The information contained in this document is for reference only and does not constitute a contract. The user must refer to the original document for the complete information. The user must refer to the original document for the complete information. The user must refer to the original document for the complete information.	020	UNIFILAIRE / SINGLE LINE DIAGRAM	00													
		021	UNIFILAIRE / SINGLE LINE DIAGRAM	00	01												
		032	ALIMENTATION 230VCA / 230VAC POWER SUPPLY	00													
		033	ALIMENTATION 24VCC / 24VDC POWER SUPPLY	00													
		034	DISTRIBUTION DES POLARITES 24VCC / 24VDC DISTRIBUTION	00													
		035	DISTRIBUTION DES POLARITES 24VCC / 24VDC DISTRIBUTION	00													
		038	COMMANDE ONDULEURS / INVERTERS CONTROL	00													
		040	EXTENSEUR MODBUS RS485 24VCC / RS485 LINK EXTENDER 24VDC	00													
		041	EXTENSEUR MODBUS RS485 24VCC / RS485 LINK EXTENDER 24VDC	00													
		042	EXTENSEUR MODBUS RS485 24VCC / RS485 LINK EXTENDER 24VDC	00													
C	The technical information contained in this document is the exclusive property of Schneider Electric Industries S.A.S. and cannot be used or disclosed to third parties without the written consent of Schneider Electric Industries S.A.S. The information contained in this document is for reference only and does not constitute a contract. The user must refer to the original document for the complete information. The user must refer to the original document for the complete information. The user must refer to the original document for the complete information.	044	COFFRET OPTIQUE FIDJI V2 / OPTICAL BOX FIDJI V2	00	01												
		045	SWITCH ETHERNET / ETHERNET SWITCH	00	01												
		050	PC DE TELEGESTION / REMOTE MANAGEMENT PC	00	01												
		052	API NAPAC / PLC NAPAC	00	01												
		054	CARTE 16 ENTREES TOR ENTREES 1 A 8 / 16 DIGITAL INPUTS BOARD INPUTS 1 TO 8	00													
		055	CARTE 16 ENTREES TOR ENTREES 9 A 16 / 16 DIGITAL INPUTS BOARD INPUTS 9 TO 16	00													
		056	CARTE 16 ENTREES TOR ENTREES 1 A 8 / 16 DIGITAL INPUTS BOARD INPUTS 1 TO 8	00													
		057	CARTE 16 ENTREES TOR ENTREES 9 A 16 / 16 DIGITAL INPUTS BOARD INPUTS 9 TO 16	00													
		058	CARTE 4 ENTREES ANALOGIQUES UNIVERSELLES / 4 UNIVERSAL ANALOG INPUTS BOARD	00													
		059	CARTE 4 SORTIES TOR RELAIS ELECTROMECHANIQUES / 4 DIGITAL OUTPUTS BOARD ELECTROMECHANICAL RELAYS	00													
D	The technical information contained in this document is the exclusive property of Schneider Electric Industries S.A.S. and cannot be used or disclosed to third parties without the written consent of Schneider Electric Industries S.A.S. The information contained in this document is for reference only and does not constitute a contract. The user must refer to the original document for the complete information. The user must refer to the original document for the complete information. The user must refer to the original document for the complete information.	060	CARTE 4 SORTIES TOR RELAIS ELECTROMECHANIQUES / 4 DIGITAL OUTPUTS BOARD ELECTROMECHANICAL RELAYS	00													
		061	RESERVES SUR BORNES / SPARES ON TERMINALS	00													
		150	BORNIER : =N201+AP01-X1 / TERMINAL BLOCK : =N201+AP01-X1	00													
		151	BORNIER : =N201+AP01-X2 / TERMINAL BLOCK : =N201+AP01-X2	00													
		152	BORNIER : =N201+AP01-X3 / TERMINAL BLOCK : =N201+AP01-X3	00													
		153	BORNIER : =N201+AP01-X4 / TERMINAL BLOCK : =N201+AP01-X4	00													
		154	BORNIER : =N201+AP01-X021 / TERMINAL BLOCK : =N201+AP01-X021	00													
		155	BORNIER : =N201+AP01-X031 / TERMINAL BLOCK : =N201+AP01-X031	00													
		156	BORNIER : =N201+AP01-X041 / TERMINAL BLOCK : =N201+AP01-X041	00													
		157	BORNIER : =N201+AP01-X044 / TERMINAL BLOCK : =N201+AP01-X044	00													
	Archivage Modified	200	NOMENCLATURE / PART LIST	00													
		201	NOMENCLATURE / PART LIST	00													
		PAGE RECAPITULATIVE / SUMMARY			MONITORING PHOTOVOLTAÏQUE / PHOTOVOLT AIC MONITORING CASINOLOT 4 PESSAC-RODEZ-ARLES					02985574 Projet - No commande Project Order No. FPVTB0540		Indice Rev 01	Folio Sheet 002				

1		2		3		4		5		6		7		8		9		10			
SYMBÔLE SYMBOL		CODE	LEGENDE DESCRIPTION		SYMBÔLE SYMBOL	CODE	LEGENDE DESCRIPTION		SYMBÔLE SYMBOL	CODE	LEGENDE DESCRIPTION		SYMBÔLE SYMBOL	CODE	LEGENDE DESCRIPTION		SYMBÔLE SYMBOL	CODE	LEGENDE DESCRIPTION		
A			CONTACT A FERMETURE MAKE CONTACT				DISPOSITIF D'ACCROCHAGE EN PRISE DEVICE FOR RESTRICTING MOVEMENT BLOCKED POSITION			G	ELEMENT DE PILE OU ACCUMULATEUR PRIMARY CELL OR ACCUMULATOR										
			CONTACT A OUVERTURE BREAK CONTACT				DISPOSITIF D'ACCROCHAGE LIBRE DEVICE FOR RESTRICTING MOVEMENT UNBLOCKED POSITION														
			CONTACT INVERSEUR CHANGE OVER CONTACT				TERRE DE PROTECTION EARTH PROTECTION			H	LAMPE DE SIGNALISATION SIGNAL LAMP										
B			CONTACT NO TEMPORISE AU TRAVAIL MAKE CONTACT DELAY WHEN OPERATING				TERRE FONCTIONNELLE FUNCTIONAL EARTH			H	VOYANT MECANIQUE DE SIGNALISATION MECHANICAL INDICATOR										
			CONTACT NF TEMPORISE AU TRAVAIL BREAK CONTACT DELAY WHEN OPERATING				TERRE EARTH			H	AVERTISSEUR HORN										
			CONTACT NO TEMPORISE AU REPOS MAKE CONTACT DELAY WHEN RELEASING			B	COMMANDE PAR PRESSION OPERATED BY PRESSURE			H	SONNERIE HORN										
C			CONTACT NF TEMPORISE AU REPOS MAKE CONTACT DELAY WHEN RELEASING			B	COMMANDE PAR TEMPERATURE OPERATED BY TEMPERATURE														
			CONTACT DE PASSAGE A LA FERMETURE PASSING MAKE CONTACT CLOSING MOMENTARILY DURING OPERATION			B	COMMANDE PAR NIVEAU OPERATED BY LEVEL			KA	RELAIS - ORGANES DE COMMANDE RELAY - COIL										
			CONTACT DE PASSAGE A L'OUVERTURE PASSING BREAK CONTACT CLOSING MOMENTARILY DURING OPERATION							KA	RELAIS A MISE AU REPOS RETARDEE SLOW RELEASING RELAY COIL										
D			CONTACT A FERMETURE ANTERIEURE AUX AUTRES CONTACTS DE L'ENSEMBLE MAKE CONTACT WHICH OPERATES EARLIER RELATIVE TO THE ASSEMBLY OF CONTACT			C	CAPACITE - CONDENSATEUR CAPACITANCE - CAPACITOR			KA	RELAIS A MISE AU TRAVAIL RETARDEE SLOW OPERATING RELAY COIL										
			CONTACT A FERMETURE POSTERIEURE AUX AUTRES CONTACTS DE L'ENSEMBLE MAKE CONTACT WHICH OPERATES LATER RELATIVE TO THE ASSEMBLY OF CONTACT			E	RESISTANCE DE CHAUFFAGE HEATING RESISTOR			KM	CONTACTEUR CONTACTOR										
			CONTACT A OUVERTURE POSTERIEURE AUX AUTRES CONTACTS DE L'ENSEMBLE BREAK CONTACT WHICH OPERATES LATER RELATIVE TO THE ASSEMBLY OF CONTACT																		
E			CONTACT A OUVERTURE ANTERIEURE AUX AUTRES CONTACTS DE L'ENSEMBLE MAKE CONTACT WHICH OPERATES EARLIER RELATIVE TO THE ASSEMBLY OF CONTACT			F	PARAFODRE LIGHTNING ARRESTER			P	INDICATEUR - SYMBÔLE GENERAL INDICATING INSTRUMENT - GENERAL SYMBOL										
			DISPOSITIF D'EMBROCHAGE WITHDRAWABLE DEVICE			F	COUPE CIRCUIT FUSE			P	ENREGISTREUR - SYMBÔLE GENERAL RECORDING INSTRUMENT - GENERAL SYMBOL										
			VERROUILLAGE MECANIQUE MECHANICAL INTERLOCK			F	DETECTION DE SURINTENSITE - EFFET THERMIQUE OVERCURRENT DETECTION - THERMAL EFFECT			P	COMPTEUR - SYMBÔLE GENERAL INTEGRATING METER - GENERAL SYMBOL										
F			ENROULEMENT WINDING			F	DETECTION DE SURINTENSITE - EFFET MAGNETIQUE OVERCURRENT DETECTION - MAGNETIC EFFECT														

1		2		3		4		5		6		7		8		9		10					
SYMBÔLE SYMBOL		CODE	LEGENDE DESCRIPTION		SYMBÔLE SYMBOL		CODE	LEGENDE DESCRIPTION		SYMBÔLE SYMBOL		CODE	LEGENDE DESCRIPTION		SYMBÔLE SYMBOL		CODE	LEGENDE DESCRIPTION					
A		Q	INTERRUPTEUR SWITCH			S	COMMANDE PAR LEVIER OPERATED BY LEVER			U	CONVERTISSEUR TRANSDUCER												
		Q	DISJONCTEUR CIRCUIT BREAKER			S	COMMANDE PAR CLEF OPERATED BY KEY																
		Q	SECTIONNEUR DISCONNECTOR (ISOLATOR)			S	TL OUTPL POUR SECTIONNEUR DISCREPANCY SWITCH FOR DISCONNECTOR			V	FONCTION REDRESSEUSE RECTIFYING FUNCTION												
		Q	INTERRUPTEUR SECTIONNEUR SWITCH DISCONNECTOR			S	TL OUTPL POUR DISJONCTEUR DISCREPANCY SWITCH FOR CB																
		Q	COMMANDE PAR MOTEUR OPERATED BY MOTOR			S	BOITIER DE SIGNALISATION ALARM ANNUNCIATOR																
B																							
		R	SHUNT SHUNT			T	TRANSFORMATEUR DE COURANT UNIFILAIRE CURRENT TRANSFORMER SLD			X	BOÎTE D'ESSAI TEST BLOCK												
		R	RESISTANCE RESISTOR			T	TRANSFORMATEUR DE COURANT MULTIFILAIRE CURRENT TRANSFORMER TRIPOLAR DRAWING			X	BORNE SIMPLE ORDINARY TERMINAL BLOCK												
C						T	TRANSFORMATEUR DE TENSION MULTIFILAIRE VOLTAGE TRANSFORMER TRIPOLAR DRAWING			X	BORNE SECTIONNABLE INTERRUPTIBLE TERMINAL BLOCK												
		S	CONTACT DE POSITION NO MAKE CONTACT OF LIMIT SWITCH			T	ENROULEMENT DE TRANSFORMATEUR DE PUISSANCE - MULTIFILAIRE POWER TRANSFORMER WINDING - TRIPOLAR DRAWING			X	BORNE FUSIBLE FUSE CARRIER TERMINAL BLOCK												
		S	CONTACT DE POSITION NF BREAK CONTACT OF LIMIT SWITCH			T	ENROULEMENT DE TRANSFORMATEUR DE PUISSANCE - MULTIFILAIRE POWER TRANSFORMER WINDING - TRIPOLAR DRAWING			X	BORNE DIODE DIODE TERMINAL BLOCK												
		S	COMMUTATEUR UNIPOLAIRE A 2 DIRECTIONS SINGLE POLE POSITIONS SWITCH			T	TRANSFORMATEUR DE PUISSANCE - UNIFILAIRE POWER TRANSFORMER - SLD			X	BORNE RESISTANCE RESISTOR TERMINAL BLOCK												
		S	COMMANDE PAR POUSSOIR OPERATED BY PUSHING			T	AUTOTRANSFORMATEUR DE PUISSANCE - UNIFILAIRE POWER AUTO TRANSFORMER WINDING - SLD			X	BROCHE MALE DE CONNECTEUR MAL CONNECTOR PIN												
		S	COMMANDE PARTIRETTE OPERATED BY PULLING			T	TRANSFORMATEUR D'ISOLEMENT ISOLATING TRANSFORMER			X	BROCHE FEMELLE DE CONNECTEUR FEMALE CONNECTOR PIN												
		S	BOUTON POUSSOIR COUP DE POING EMERGENCY SWITCH																				
D																							
00		29022011		Édition originale / First issue						LISTE DES SYMBÔLES / SCHEDULE OF SYMBOLS		MONITORING PHOTOVOLTAÏQUE / PHOTOVOLTAGE MONITORING CASINOLOT 4 PESSAC-RODEZ-ARLES		Schneider Electric		02985574		Projet - No commande FPVTB0540		Indice Rev. 00		Folio Sheet 011	

LE REPERAGE DES APPAREILS EST CONFORME A LA NORME CEI. ADDITION DE 4 BLOCS DE CARACTERES

= ANN + AANN - AA*N*N : CC*C*

bloc 1* bloc 2 bloc 3 bloc 4

A = Alphabétique
N = Numérique
C = Alphanumérique
* = facultatif

Ex: =D01 +AB01 -KA1 :13

repère du N° de borne
repère du matériel (racine et n° d'ordre)
repère de l'emplacement physique (zone ; localisation)
repère essentiel (ensemble ou fonction)

bloc 1 =ANN "=" symbole distinctif repère essentiel

Repère principal caractérisant chaque subdivision importante d'une installation ou ensemble (fonctionnel). Il est facultatif.
Le 1^{er} caractère est choisi dans la "TABLE 1".
Cette table donne les lettres repères des niveaux de tension et des fonctions non spécifiques à une travée ou un niveau de tension.

bloc 2 +AANN "+" symbole distinctif repère de l'emplacement physique


Repère de l'adresse physique du matériel.
Repère de l'équipement qui contient le matériel (choix des deux premiers caractères dans la "TABLE 2").

bloc 3 -AA*N*N "-" symbole distinctif repère matériel

Repère complet du nom de l'appareil. La première lettre indique la fonction générale de l'appareil. Choix "TABLE 3".

bloc 4 :CC*C* ":" symbole distinctif repère du N° de borne

Repère composé indifféremment de lettres ou de chiffres.

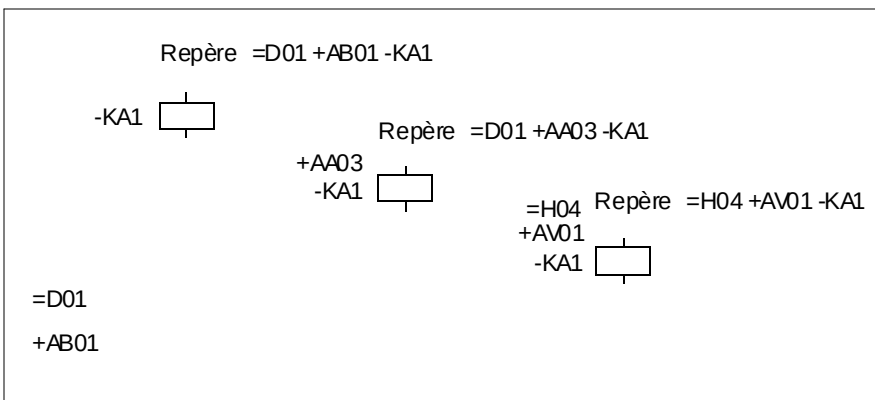

ACCORDING TO STANDARD, MARKING OF EQUIPMENTS IS MADE WITH 4 BLOCKS OF CHARACTERS

= ANN + AANN - AA*N*N : CC*C*

block 1* block 2 block 3 block 4

A = Alphabetic
N = Numeric
C = Alphanumeric
* = optional

Ex: =D01 +AB01 -KA1 :13

terminal designation
identification of item (root & sequence N°)
location of item (zone ; location)
higher-level designation (set or function)

block 1 =ANN "=" distinctive symbol higher level designation

Item designation for any major part of plant or function. Optional.
First character is given by "TABLE 1".
This table gives codes for voltage levels and for no attached functions to a particular bay or voltage level.

block 2 +AANN "+" distinctive symbol location of item


Designation for location item.
Indicates equipment which contains the item (choice of the 2 first characters "TABLE 2").

block 3 -AA*N*N "-" distinctive symbol identification of item

Complete designation of item identification. 1st character indicates general function of item. Choice "TABLE 3".

block 4 :CC*C* ":" distinctive symbol terminal designation

Designation composed of letters or numbers.

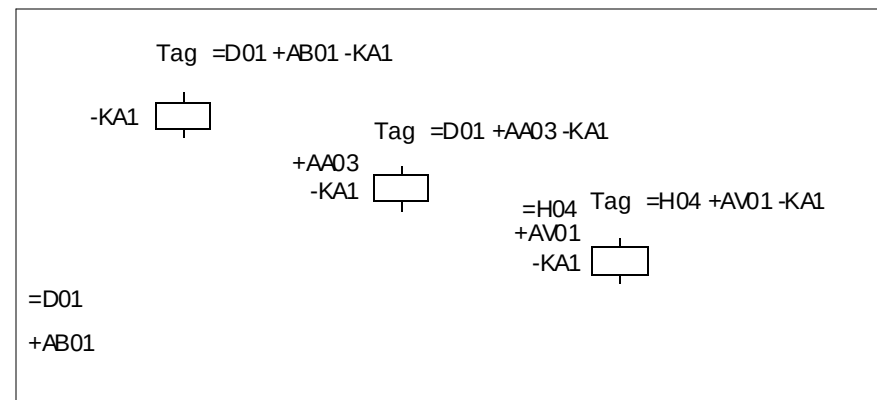

PRINCIPE DE REPERAGE /
PRINCIPLE OF MARKING

MONITORING PHOTOVOLTAÏQUE /
PHOTOVOLTAIC MONITORING
CASINO LOT 4
PESSAC-RODEZ-ARLES

Schneider
Electric

02985574

Projet - No commande
Project - Order No
FPVTB0540

Indice
Rev
00

Folio
Sheet
012

3

C

E

NO ATTACHED FUNCTIONS TO A PARTICULAR BAY
OR A VOLTAGE LEVEL

OU A UN NIVEAU DE TENSION

LETTRES	FONCTIONS
Q	MESURE - COMPTAGE - ENREGISTREMENT
R	PROTECTIONS
S	ECLAIRAGE - CLIMATISATION - INSTAL DOMESTIQUE
T	TRANSFORMATEUR
U	COMMUNS - TRANCHE GENERALE
V	
W	INTERFACES
X	CONSIGNATEURS - OSCILLOPERTURBOGRAPHIE
Y	SYSTEME TELECOMMUNICATION
Z	CABLE

EXEMPLES : +E04 Indique que l'emplacement appartient en totalité à la travée 110kV N° 04
=C05 Indique la travée 400kV N° 05
=R01 Indique l'ensemble fonctionnel "PROTECTION INCENDIE" N° 01

OR A VOLTAGE LEVEL

LETTRES	VOLTAGE
Q	MEASURING -RECORDING -METERING
R	PROTECTIONS
S	LIGHTING, AIR CONDITIONING, DOMESTIC
T	TRANSFORMER
U	COMMONS
V	
W	INTERFACES
X	EVENTS & FAULT RECORDER, SUPERVISION
Y	TELECOMMUNICATION SYSTEM,ALARMS STATUS
Z	CABLE

EXAMPLES: +E04 Indicates that the localisation is fully attached to bay110kV/ N° 04
 =C05 Indicates bay400kV N° 05
 =R01 Indicates the function "FIRE PROTECTION"N° 01

REPERES ESSENTIELS
- TABLE 1-/
HIGHER-LEVEL DESIGNATION
- TABLE 1-

MONITORING PHOTOVOLTAÏQUE /
PHOTOVOLTAÏC MONITORING
CASINO LOT 4
PESSAC - RODEZ - ARLES



02985574		
Projet - No commande Project - Order No.	Indice Rev	Folio Sheet
FPVTB0540	00	013

		1	2	3	4	5	6	7	8	9	10																																																
The technical information contained in this document is the exclusive property of Schneider Electric Industries S.A.S. and can not be used or disclosed to third parties without its written consent. Only those drawings and documents which are expressly identified as such by their title and/or reference number are intended for publication. All other rights reserved.																																																											
A																																																											
B																																																											
C	Les informations techniques sont des documents de domaine public, ils sont à disposition de tous et ne peuvent être utilisés que dans le cadre de leur destination initiale. Toute réimpression ou utilisation non autorisée sans la permission écrite de la Schneider Electric Industries S.A.S. est formellement interdite. Toute réimpression ou utilisation non autorisée sans la permission écrite de la Schneider Electric Industries S.A.S. est formellement interdite.																																																										
D																																																											
<table><tr><td colspan="2"></td><td colspan="2"></td><td colspan="2"></td><td colspan="2"></td><td colspan="2"></td><td colspan="2"></td></tr><tr><td colspan="2">00</td><td colspan="2">29022011</td><td colspan="2">Édition originale / First issue</td><td colspan="2"></td><td colspan="2"></td><td colspan="2"></td></tr><tr><td>Ind.</td><td>Date</td><td>Modification</td><td>Modification</td><td>Archiv.</td><td>Ind.</td><td>Date</td><td>Modification</td><td>Modification</td><td>Archiv.</td><td colspan="2"></td></tr><tr><td>Rev.</td><td>Date</td><td>Modification</td><td>Modification</td><td>Micro-film</td><td>Rev.</td><td>Date</td><td>Modification</td><td>Modification</td><td>Micro-film</td><td colspan="2"></td></tr></table> REPERAGE EMPLACEMENTS PHYSIQUES - TABLE 2 - / LOCATIONS OF ITEMS - TABLE 2 - MONITORING PHOTOVOLTAÏQUE / PHOTOVOLTAGE MONITORING CASINO LOT 4 PESSAC - RODEZ - ARLES  02985574 Projet - No commande Project - Order No. FPVTB0540 Indice Rev. 00 Folio Sheet 014																								00		29022011		Édition originale / First issue								Ind.	Date	Modification	Modification	Archiv.	Ind.	Date	Modification	Modification	Archiv.			Rev.	Date	Modification	Modification	Micro-film	Rev.	Date	Modification	Modification	Micro-film		
00		29022011		Édition originale / First issue																																																							
Ind.	Date	Modification	Modification	Archiv.	Ind.	Date	Modification	Modification	Archiv.																																																		
Rev.	Date	Modification	Modification	Micro-film	Rev.	Date	Modification	Modification	Micro-film																																																		
A3 suite - 11/2006																																																											

3


2


D


[illegible]


02985574		
Projet - No commande Project - Order No.	Indice Rev	Folio Sheet
FPVTB0540	00	015


	1	2	3	4	5	6	7	8	9	10																																												
A																																																						
B	ETIQUETTE COLLEE A L'INTERIEUR DE L'ARMOIRE EN HAUT SUR LE FLANC GAUCHE / NAME -PLATE STUCK INSIDE THE CUBICLE AT THE TOP ON THE LEFT SIDE 5 5 5 5 1 7 5 3 Fabricant / Manufacturer : SCHNEIDER-ELECTRIC Type : MONITORING PTR Projet / Project : FPVTB0540 N° de série / Serial N° : <N° document> - <N° série fabrication> Tension de contrôle / Control Voltage : 230 VCA / 230 VAC Date fabrication / Manufacturing date : 03 / 2011 Fabriqué en France / Made in France 1 0 0 5 0 2 A COMPLETER A LA FABRICATION TO BE DEFINED AT THE FABRICATION																																																					
C	PLAQUE DILOPHANE GRAVEE AUTO-ADHESIVE ECRITURE NOIRE SUR FOND BLANC HAUTEUR DES LETTRES : 2.5 mm CARACTERES : HELVETICA-NARROW / SELF-ADHESIVE ENGRAVED DILOPHANE PLATE BLACK WRITING ON WHITE BACKGROUND LETTERS HEIGHT : 2.5 mm CHARACTERS : HELVETICA-NARROW																																																					
D	<table><tr><td></td><td></td><td></td><td></td><td></td><td></td><td></td><td></td><td></td><td></td><td></td></tr><tr><td>01</td><td>07062011</td><td>Tel que construit / As built</td><td></td><td></td><td></td><td></td><td></td><td></td><td></td><td></td></tr><tr><td>00</td><td>29022011</td><td>Edito n originale / First issue</td><td></td><td></td><td></td><td></td><td></td><td></td><td></td><td></td></tr><tr><td>Ind. Rev.</td><td>Date</td><td>Modifica tion / Modification</td><td>Archiv. Micro-film ed</td><td>Ind. Rev.</td><td>Date</td><td>Modifica tion / Modification</td><td>Archiv. Micro-film ed</td><td></td><td></td><td></td></tr></table> MARQUAGE / NAME PLATE MONIT ORING PHOTOVOLTA IQUE / PHOTOVOLTA IC MONITORING CASINOLOT 4 PESSAC-RODEZ-ARLES  02985574 Projet - No commande FPVTB0540 Indice Rev. 01 Folio Sheet 019																					01	07062011	Tel que construit / As built									00	29022011	Edito n originale / First issue									Ind. Rev.	Date	Modifica tion / Modification	Archiv. Micro-film ed	Ind. Rev.	Date	Modifica tion / Modification	Archiv. Micro-film ed			
01	07062011	Tel que construit / As built																																																				
00	29022011	Edito n originale / First issue																																																				
Ind. Rev.	Date	Modifica tion / Modification	Archiv. Micro-film ed	Ind. Rev.	Date	Modifica tion / Modification	Archiv. Micro-film ed																																															

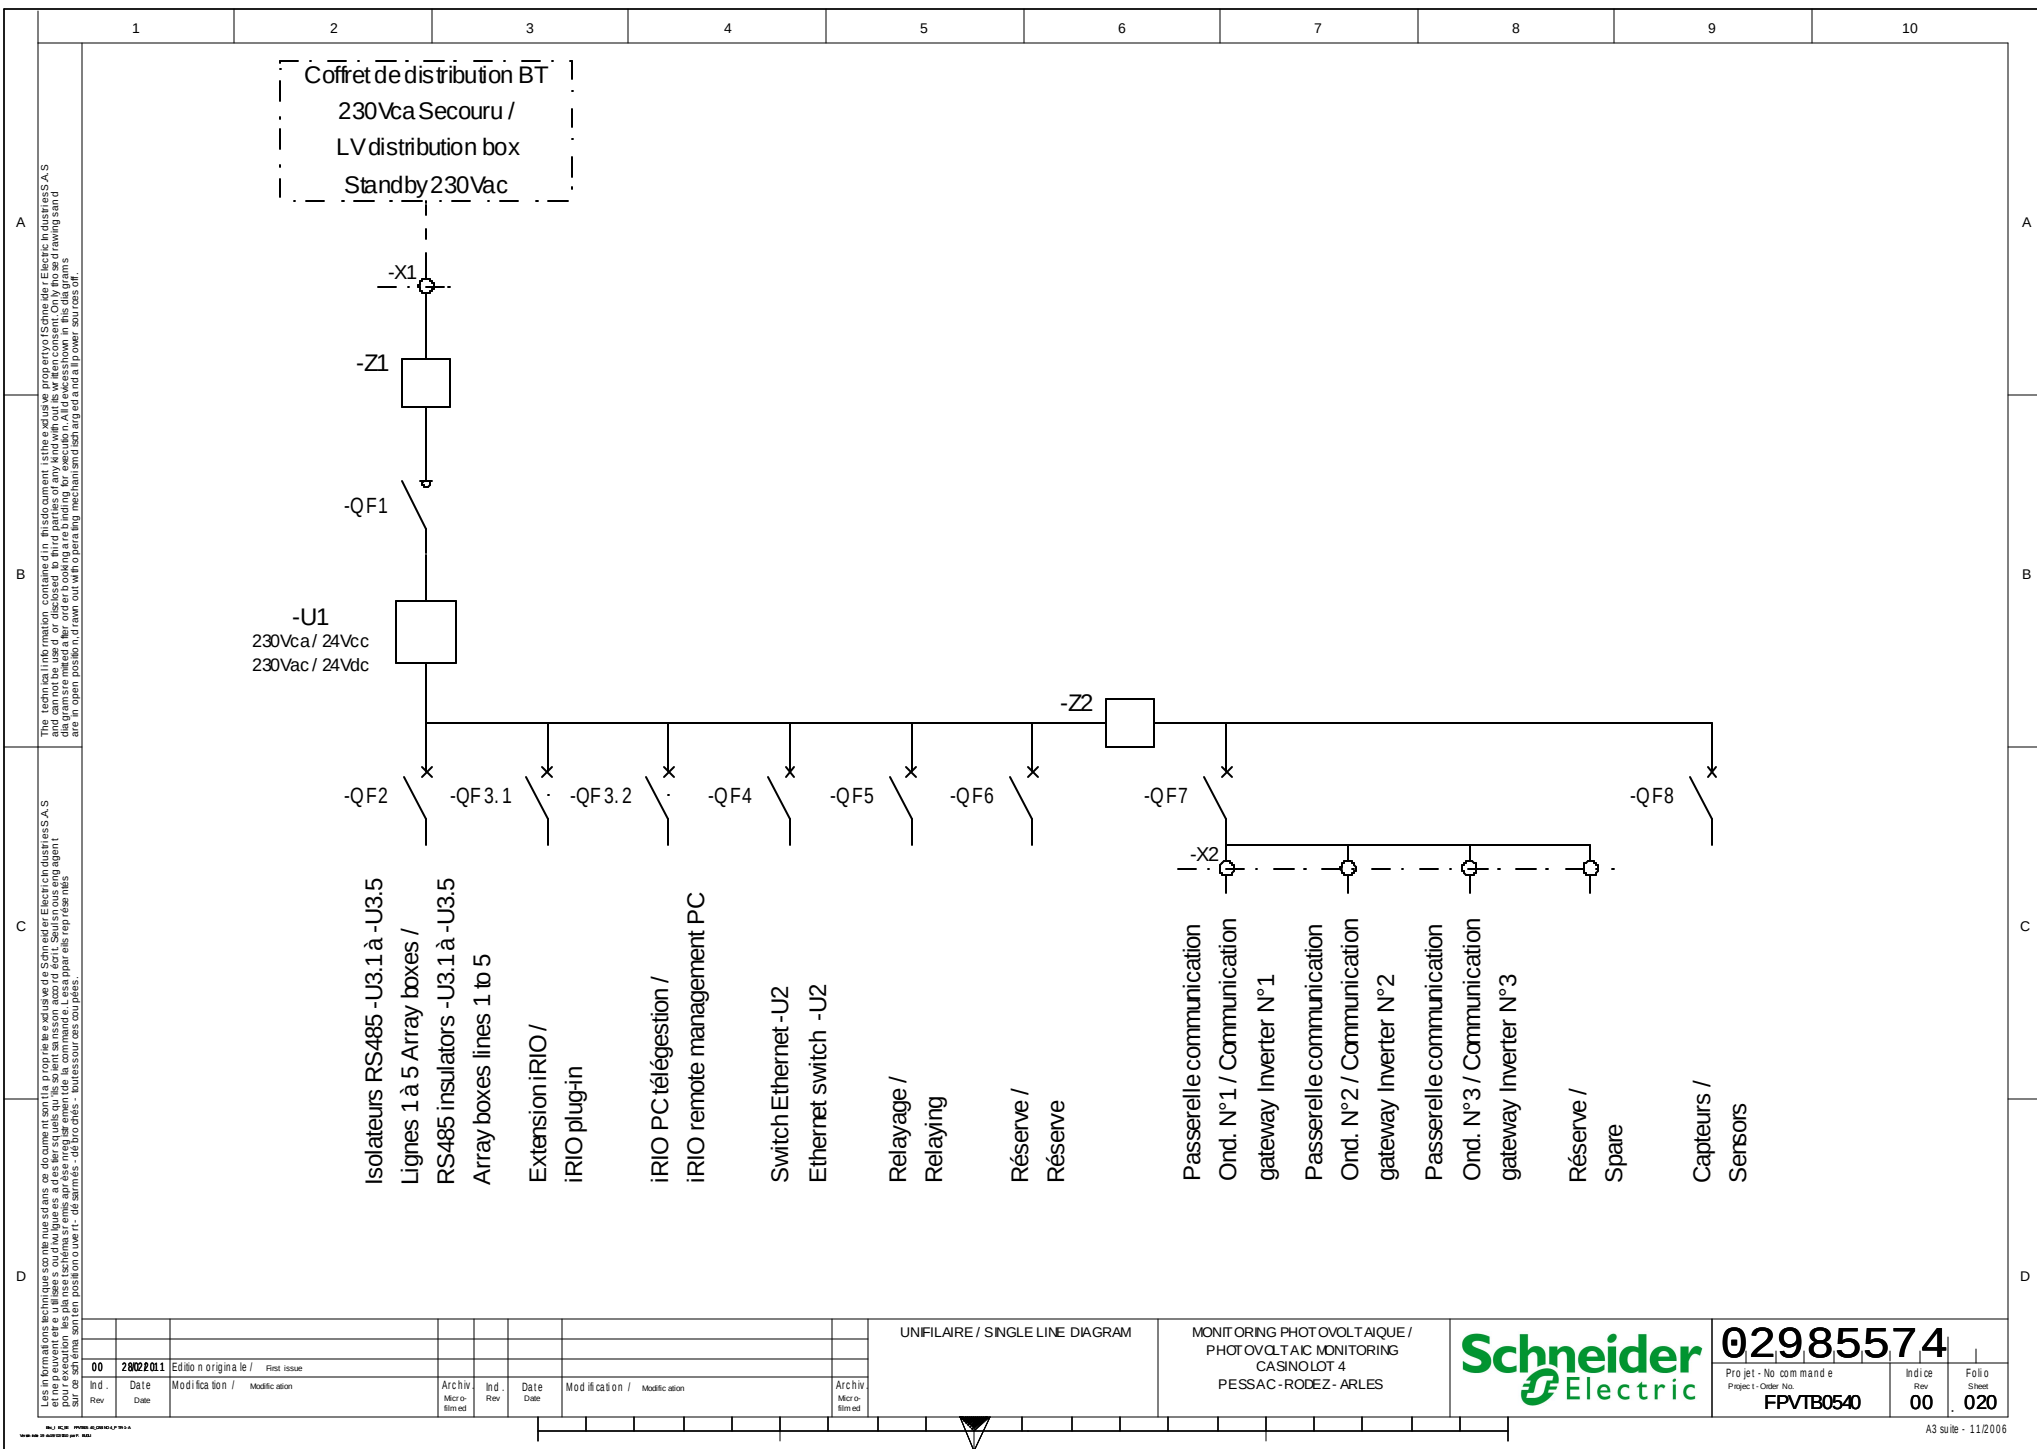


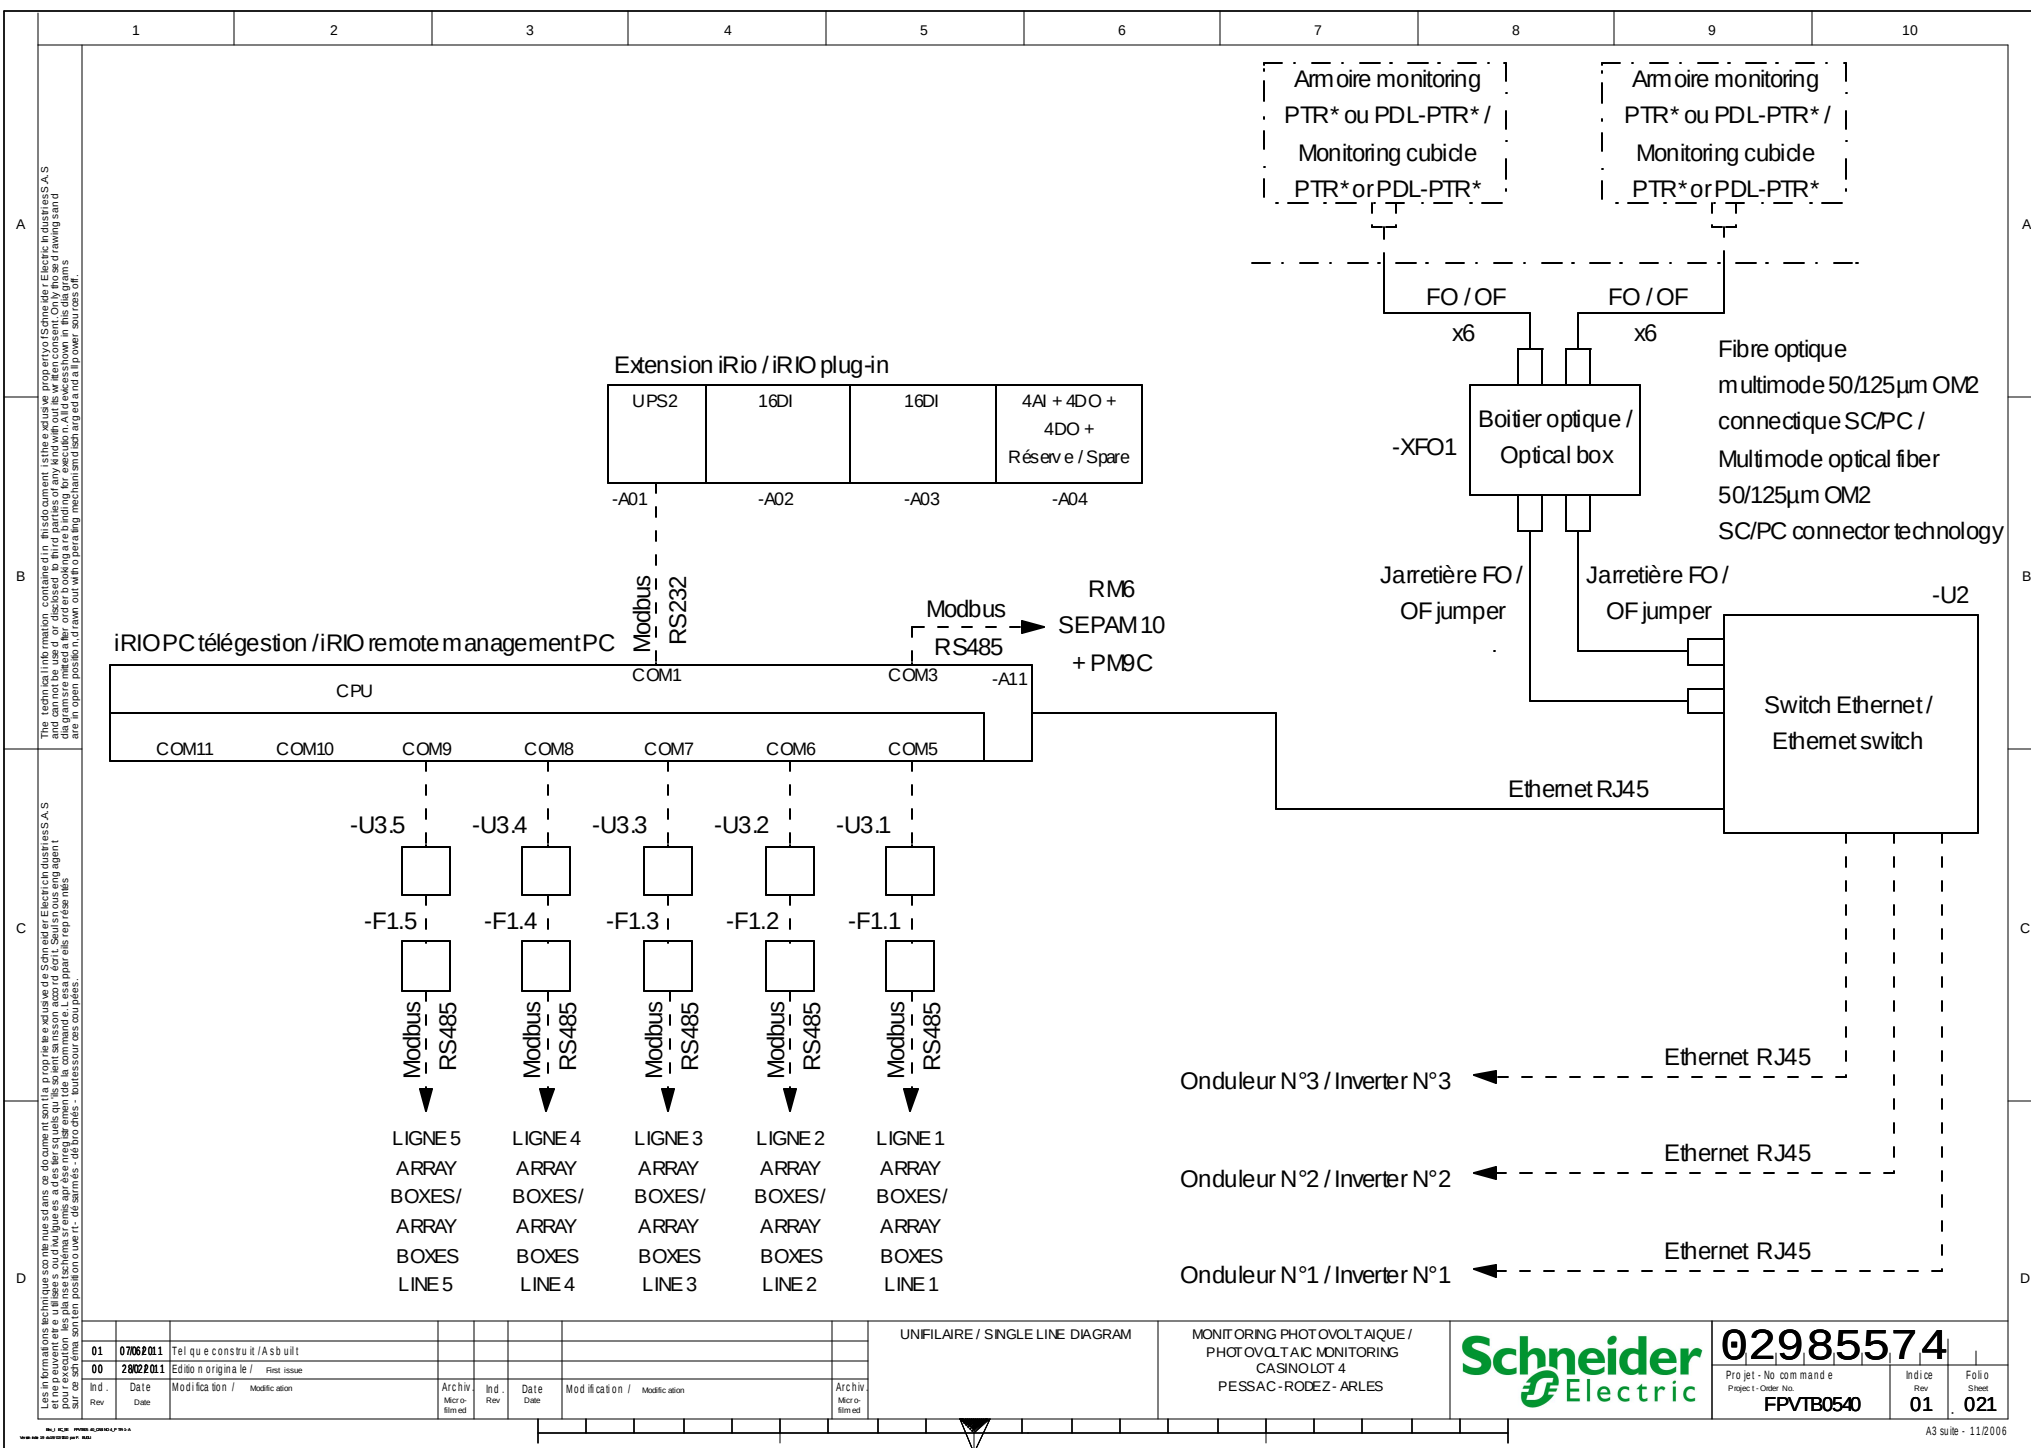


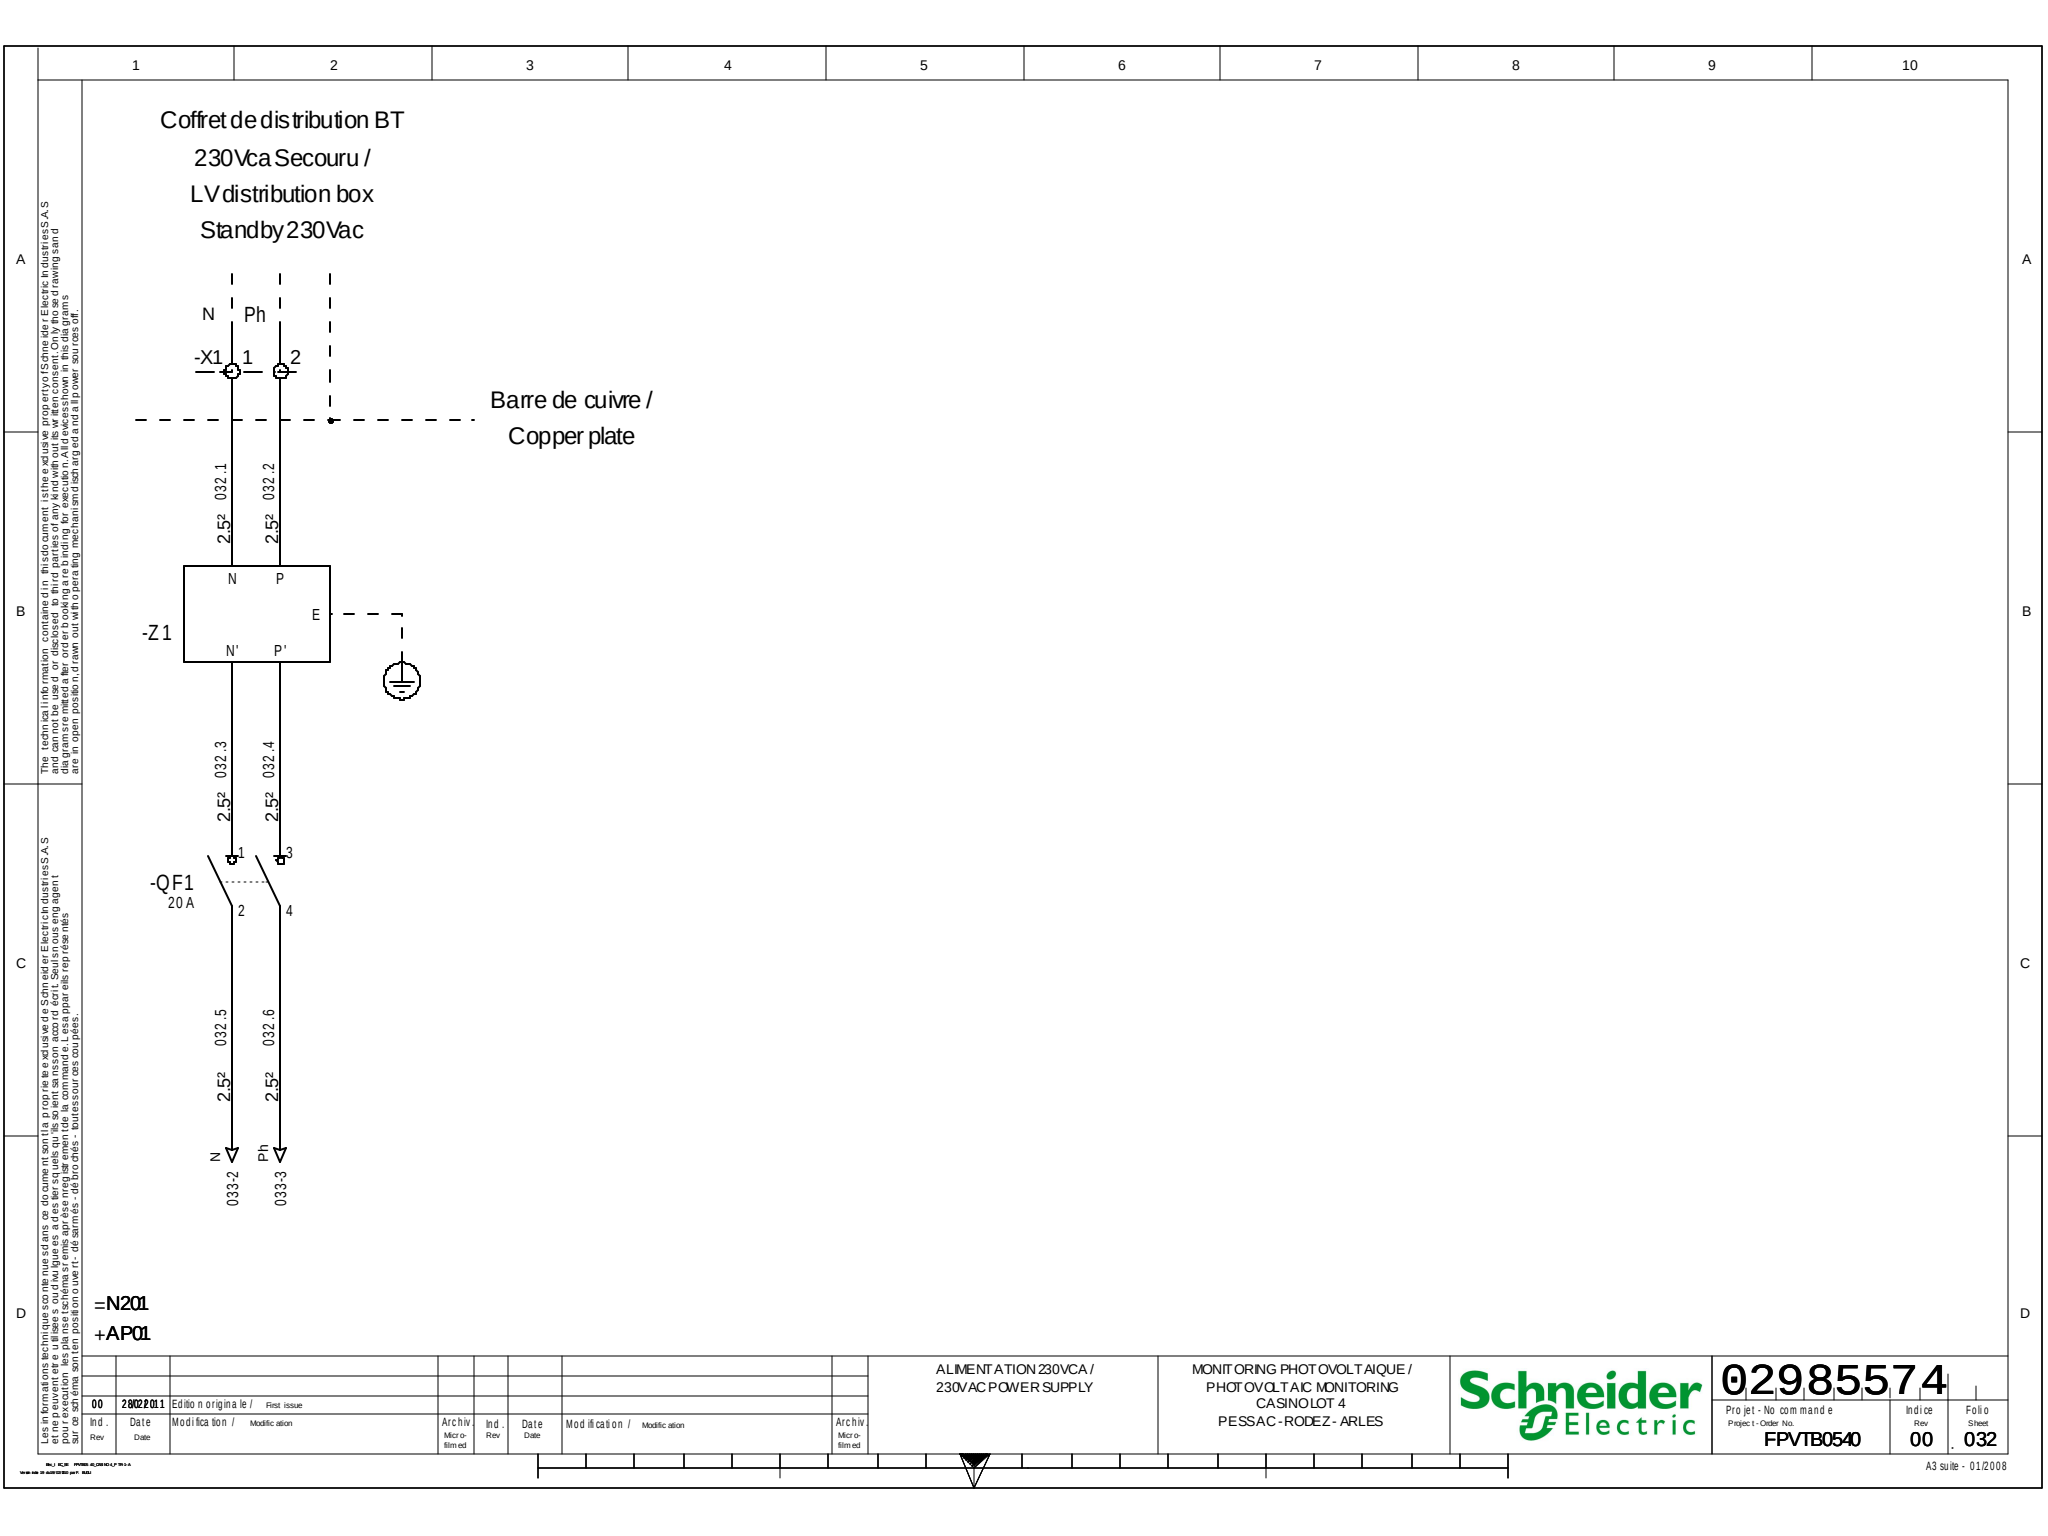

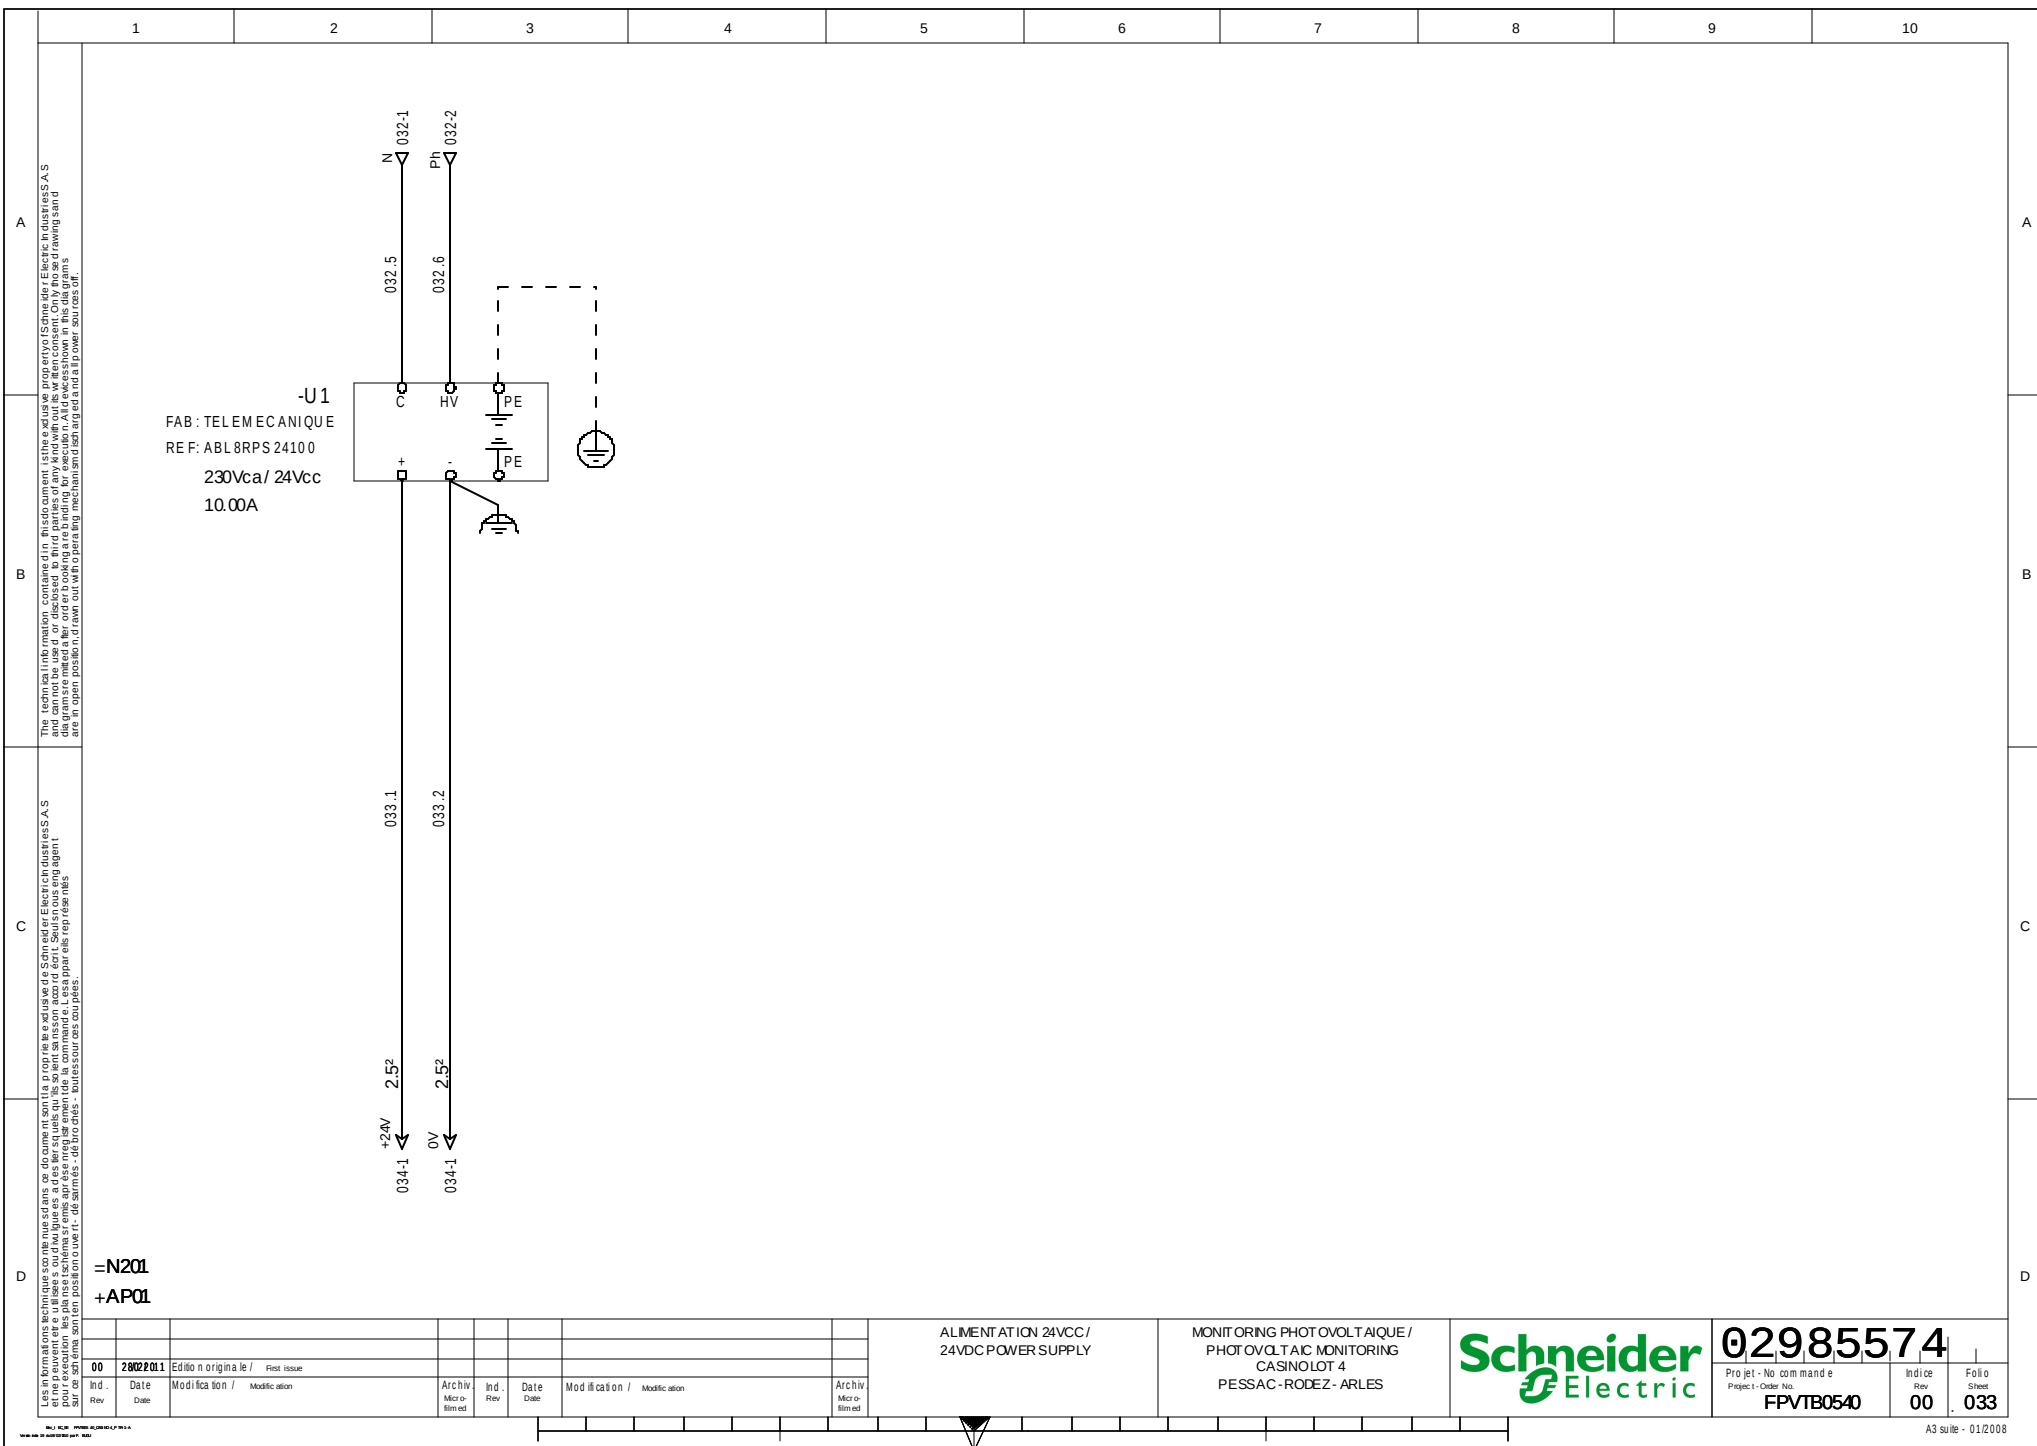

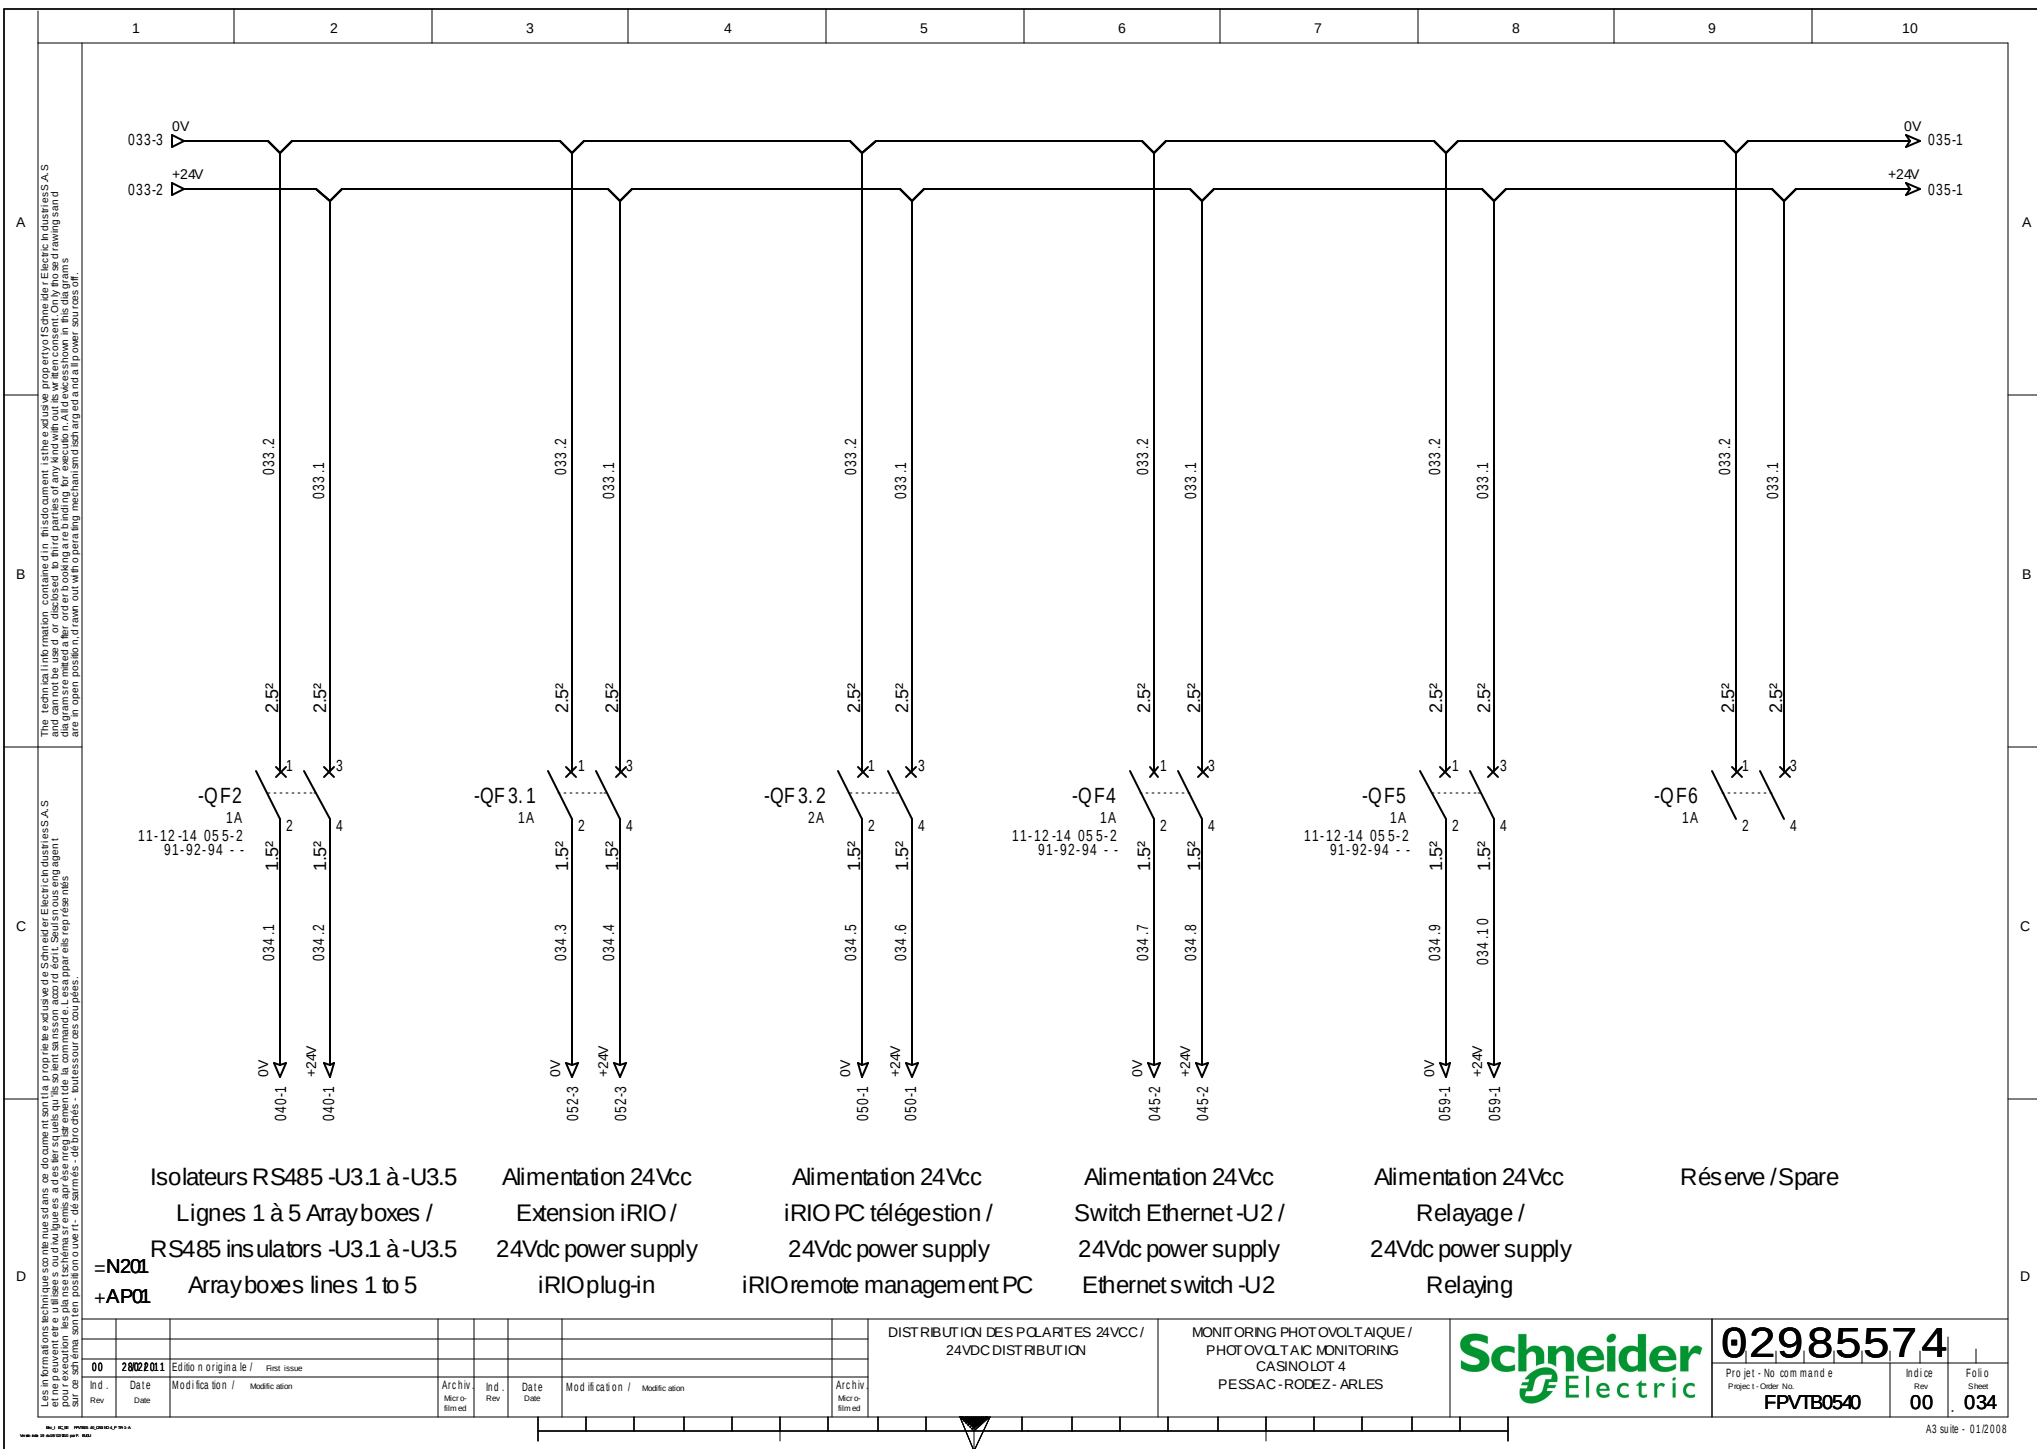

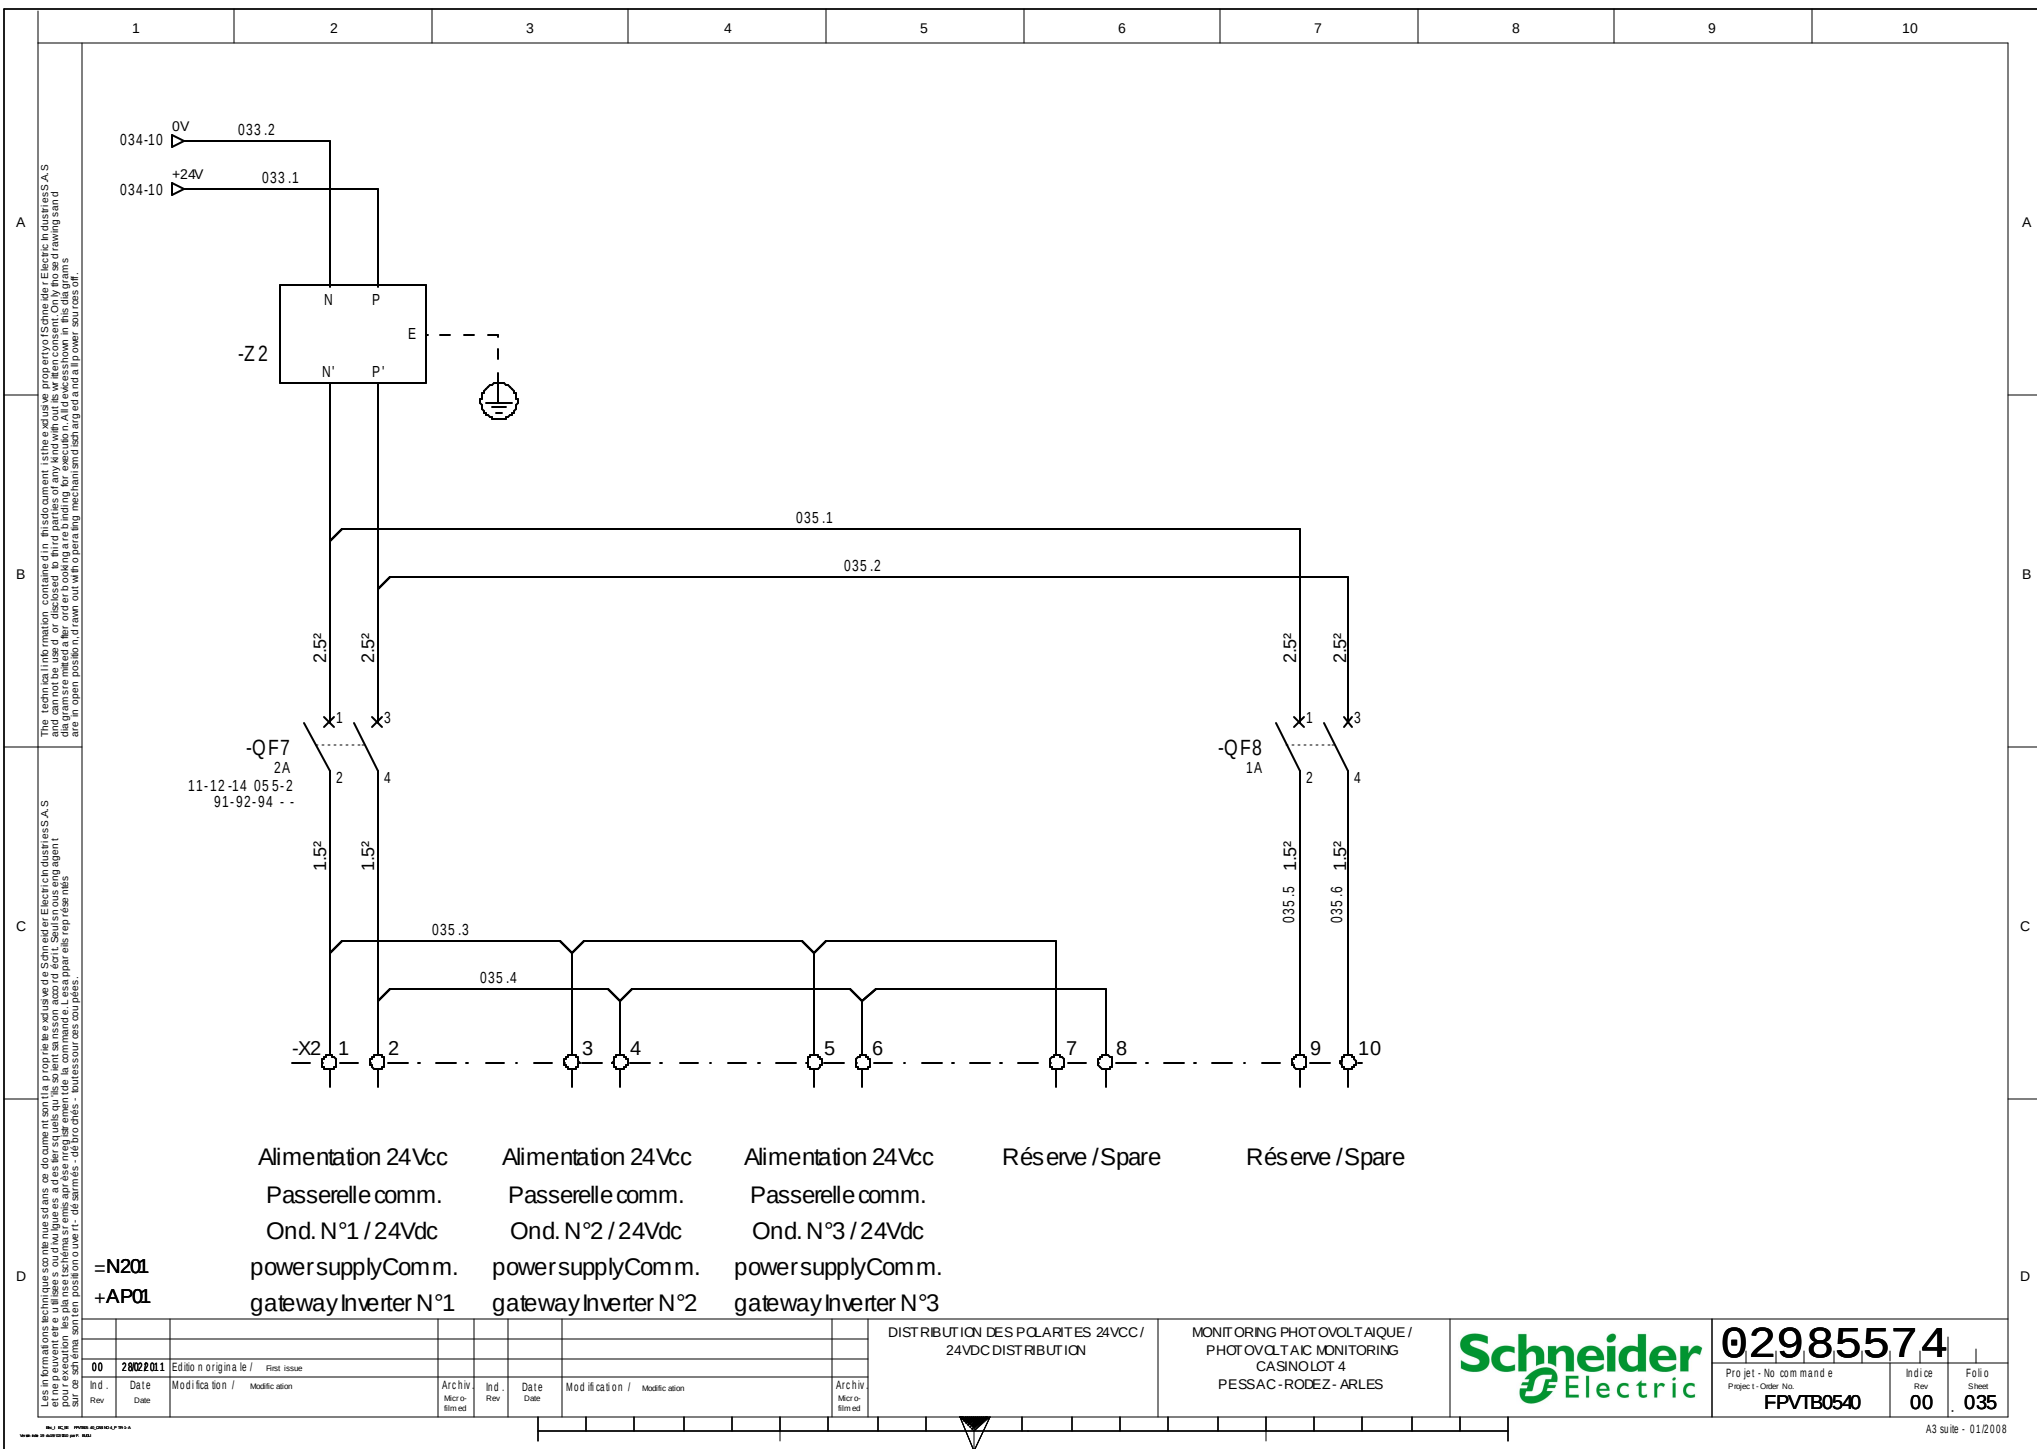

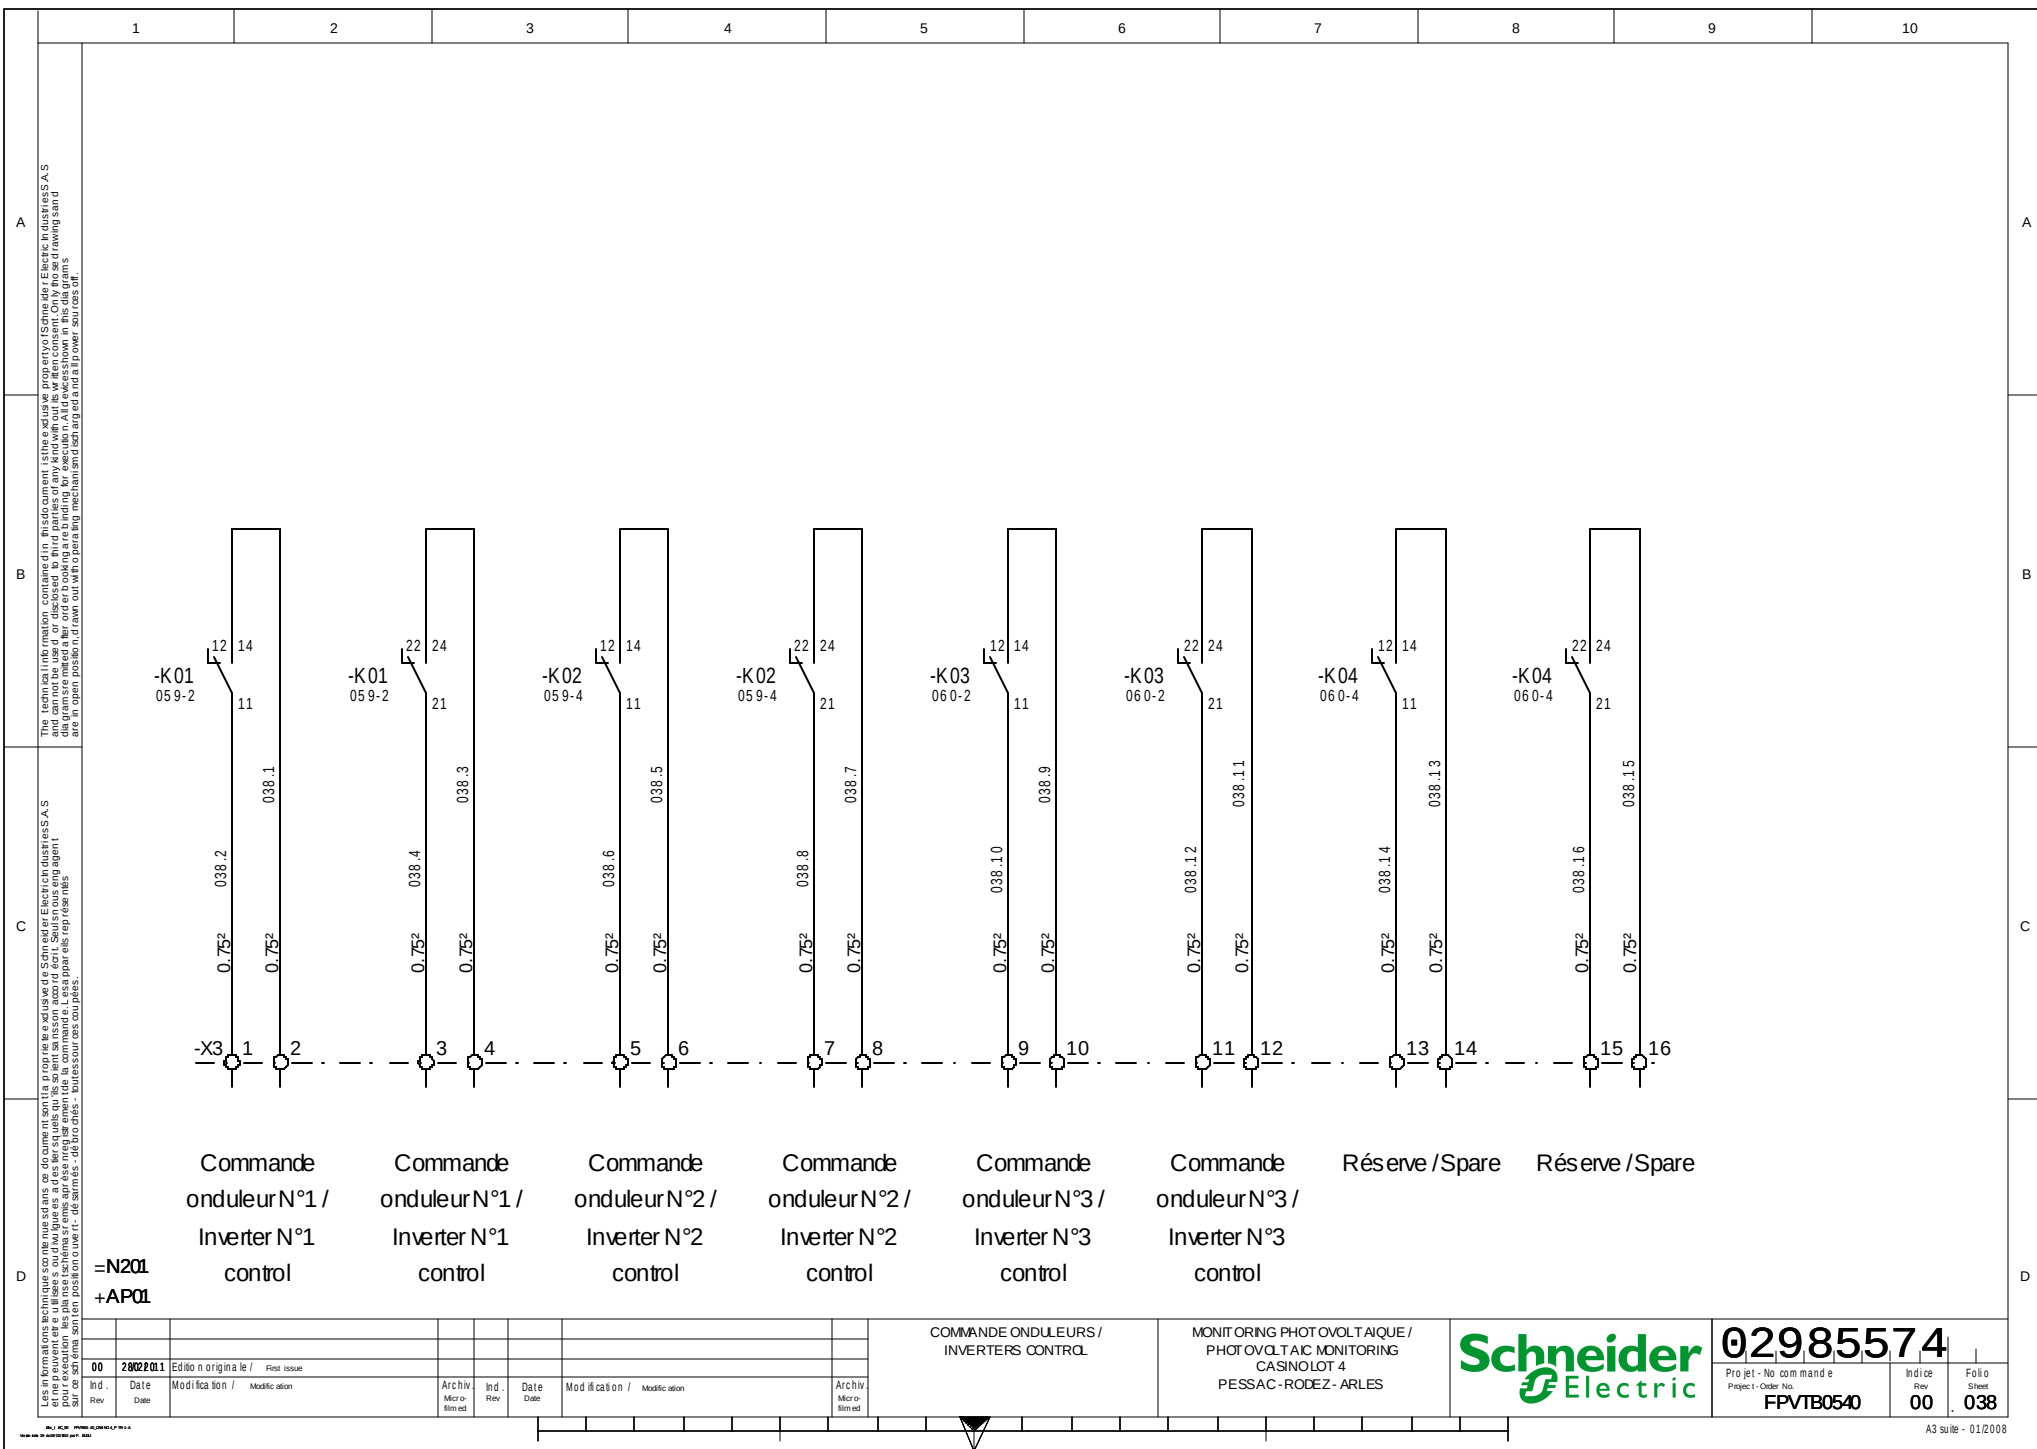

The technical information contained in this document is the exclusive property of Schneider Electric Industries SAS and cannot be used or disclosed to third parties without its written consent. Only the drawing and its annexes are in their original position and are not to be modified or altered in any way.

Les informations techniques contenues dans ce document sont la propriété exclusive de Schneider Electric Industries SAS et ne peuvent être utilisées ou divulguées à des tiers sans son accord écrit. Seuls le dessin et ses annexes sont en leur position originelle et ne doivent pas être modifiés ou altérés de quelque manière que ce soit.

D


00	29022011	Edição original / First issue							
Ind. Rev.	Date	Modificação / Modification	Arquivo / Micro-film	Ind. Rev.	Date	Modificação / Modification	Arquivo / Micro-film		

EXTENSEUR MODBUS RS485 24VCC /
RS485 LINK EXTENDER 24V/DC

MONITORING PHOTOVOLTAÏQUE /
PHOTOVOLTAIC MONITORING
CASINO LOT 4
PESSAC-RODEZ-ARLES



02985574	Projet - No commandé / Project - Order No	Indice / Rev	Folio / Sheet
	FPVTB0540	00	040

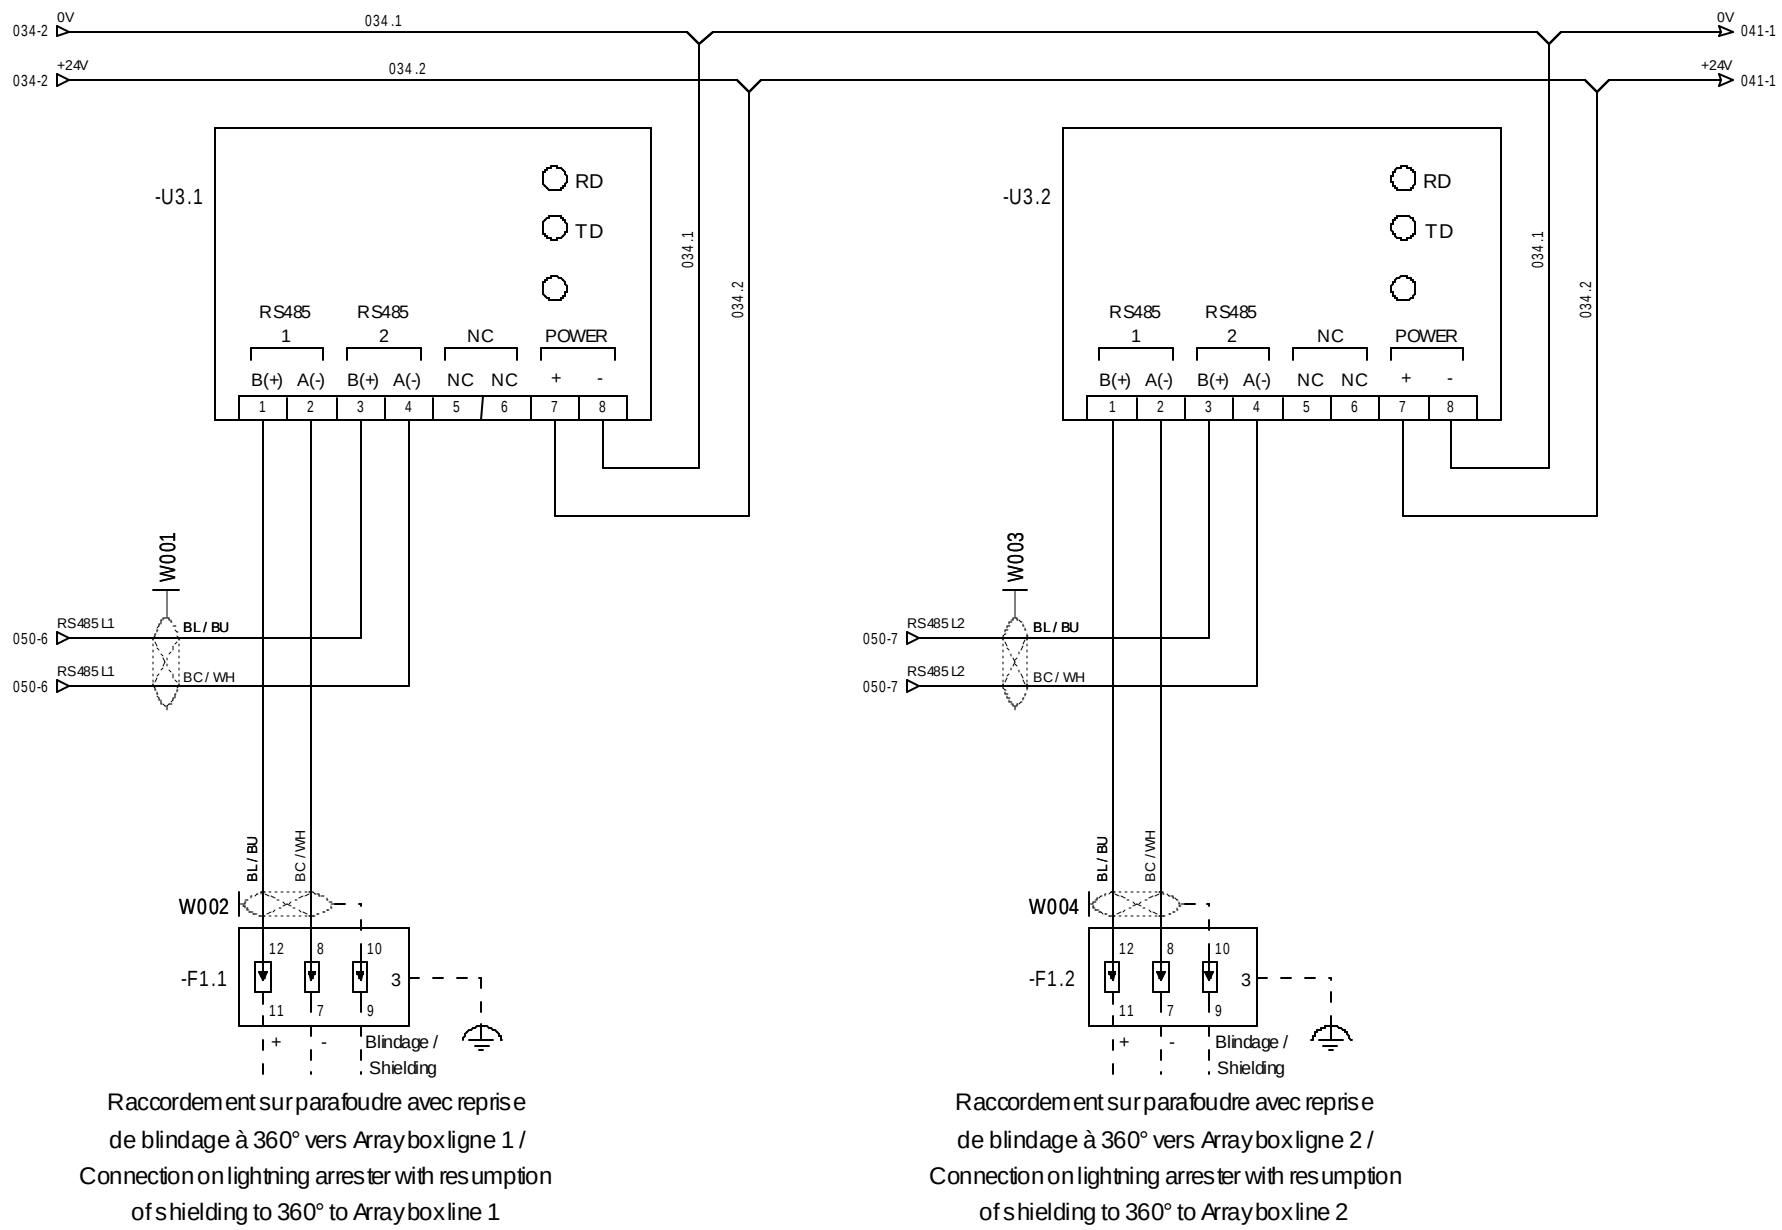

The technical information contained in this document is the exclusive property of Schneider Electric Industries SAS and cannot be used or disclosed to third parties without its written consent. Only the drawings and documents expressly authorized by Schneider Electric Industries SAS are in the open position of law and are not subject to patent.

Les informations techniques contenues dans ce document sont la propriété exclusive de Schneider Electric Industries SAS et ne peuvent être utilisées ou divulguées à des tiers sans son accord écrit. Seuls les documents et plans expressément autorisés par Schneider Electric Industries SAS sont en position de loi et ne sont pas soumis au brevet.

D


00	29022011	Edição original / First issue							
Ind. Rev.	Date	Modificação / Modification	Arquivo / Micro-filmed	Ind. Rev.	Date	Modificação / Modification	Arquivo / Micro-filmed		

EXTENSEUR MODBUS RS485 24VCC /
RS485 LINK EXTENDER 24V/DC

MONITORING PHOTOVOLTAÏQUE /
PHOTOVOLTAIC MONITORING
CASINO LOT 4
PESSAC-RODEZ-ARLES




02985574	Projet - No commandé / Project - Order No	Indice / Rev	Folio / Sheet
	FPVTB0540	00	041

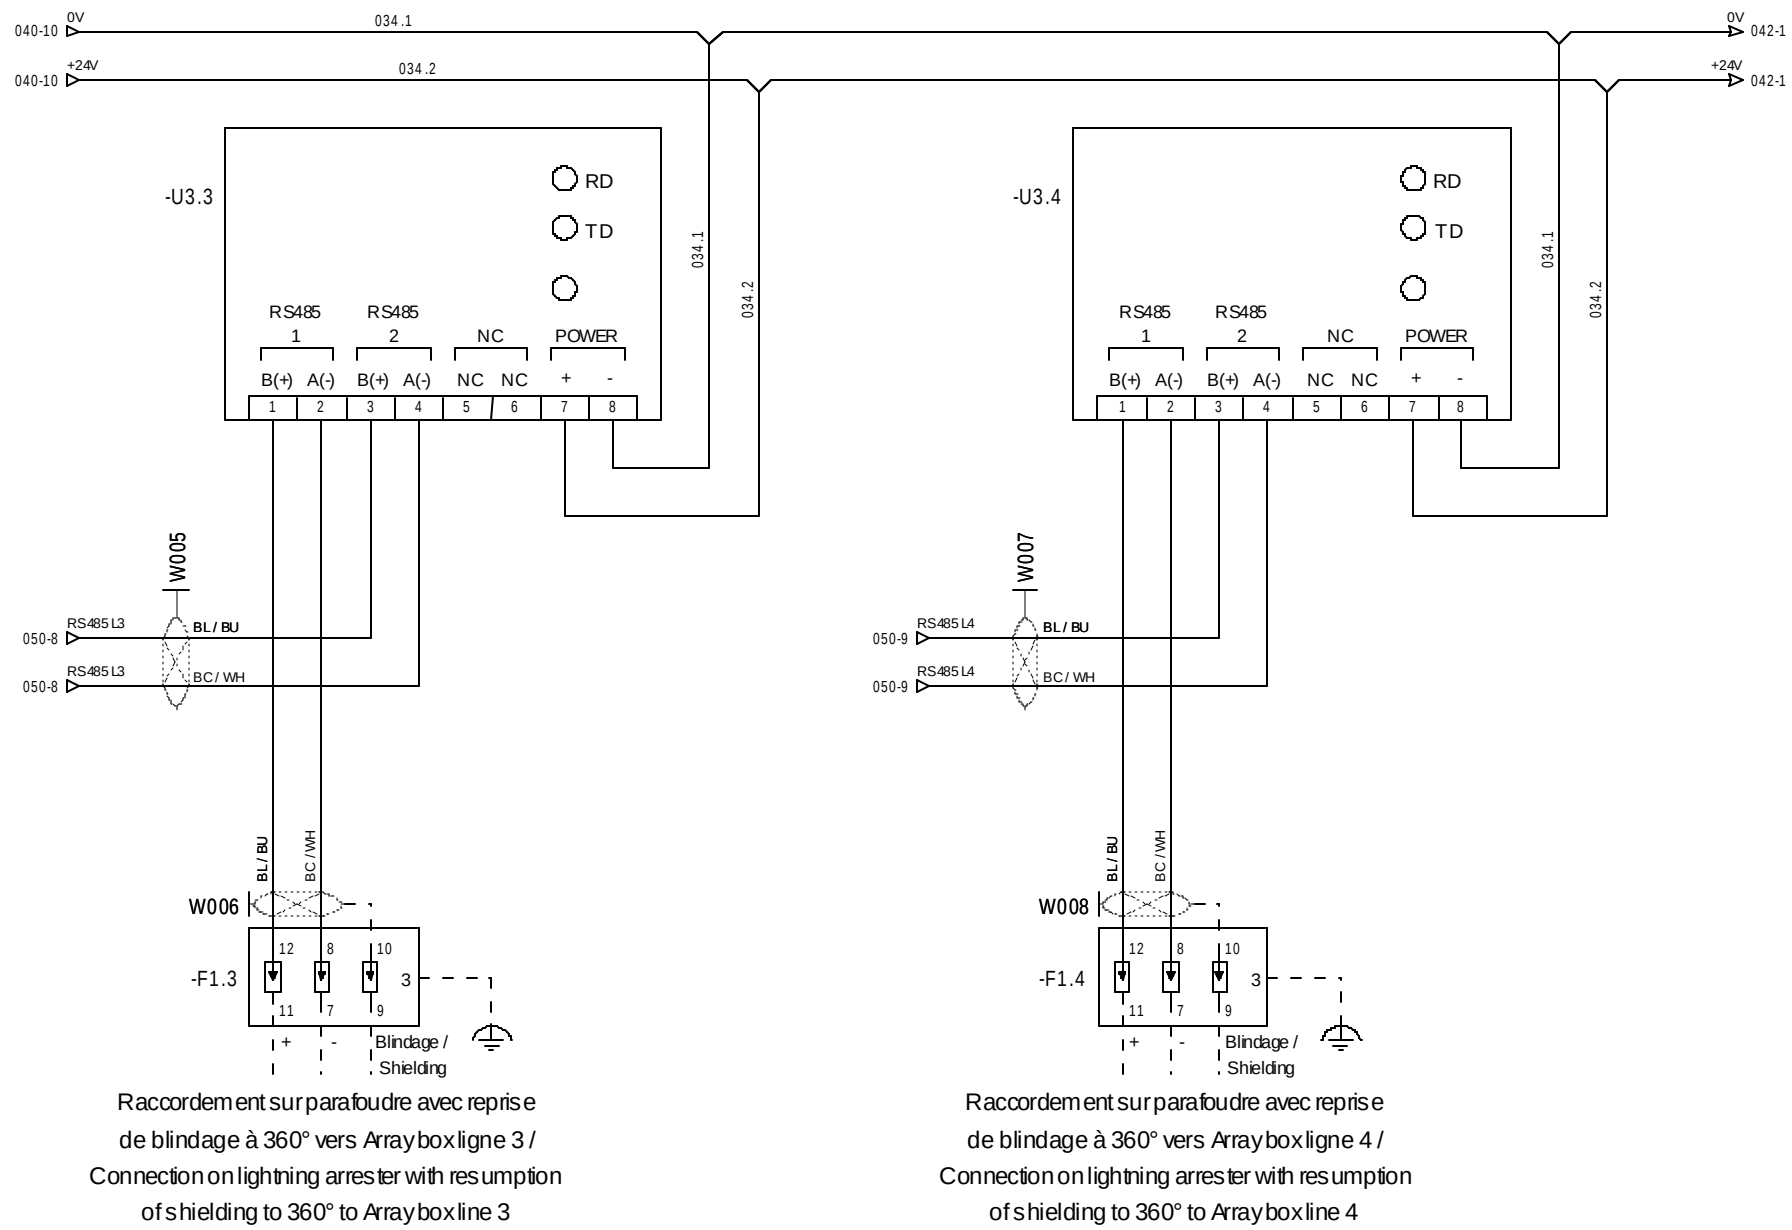

The technical information contained in this document is the exclusive property of Schneider Electric Industries S.A.S. and cannot be used or disclosed to third parties without its written consent. Only the original drawing and its electronic version are valid. The information contained in this document is not to be used for any other purpose than the one for which it was intended. The information contained in this document is not to be used for any other purpose than the one for which it was intended. The information contained in this document is not to be used for any other purpose than the one for which it was intended.

Les informations techniques sont la propriété exclusive de Schneider Electric Industries S.A.S. et ne peuvent être utilisées ou divulguées à des tiers sans son accord écrit. Seuls son original et sa version électronique sont valables. Les informations techniques contenues dans ce document ne doivent être utilisées que pour l'usage pour lequel elles ont été fournies. Les informations techniques contenues dans ce document ne doivent être utilisées que pour l'usage pour lequel elles ont été fournies. Les informations techniques contenues dans ce document ne doivent être utilisées que pour l'usage pour lequel elles ont été fournies.

D

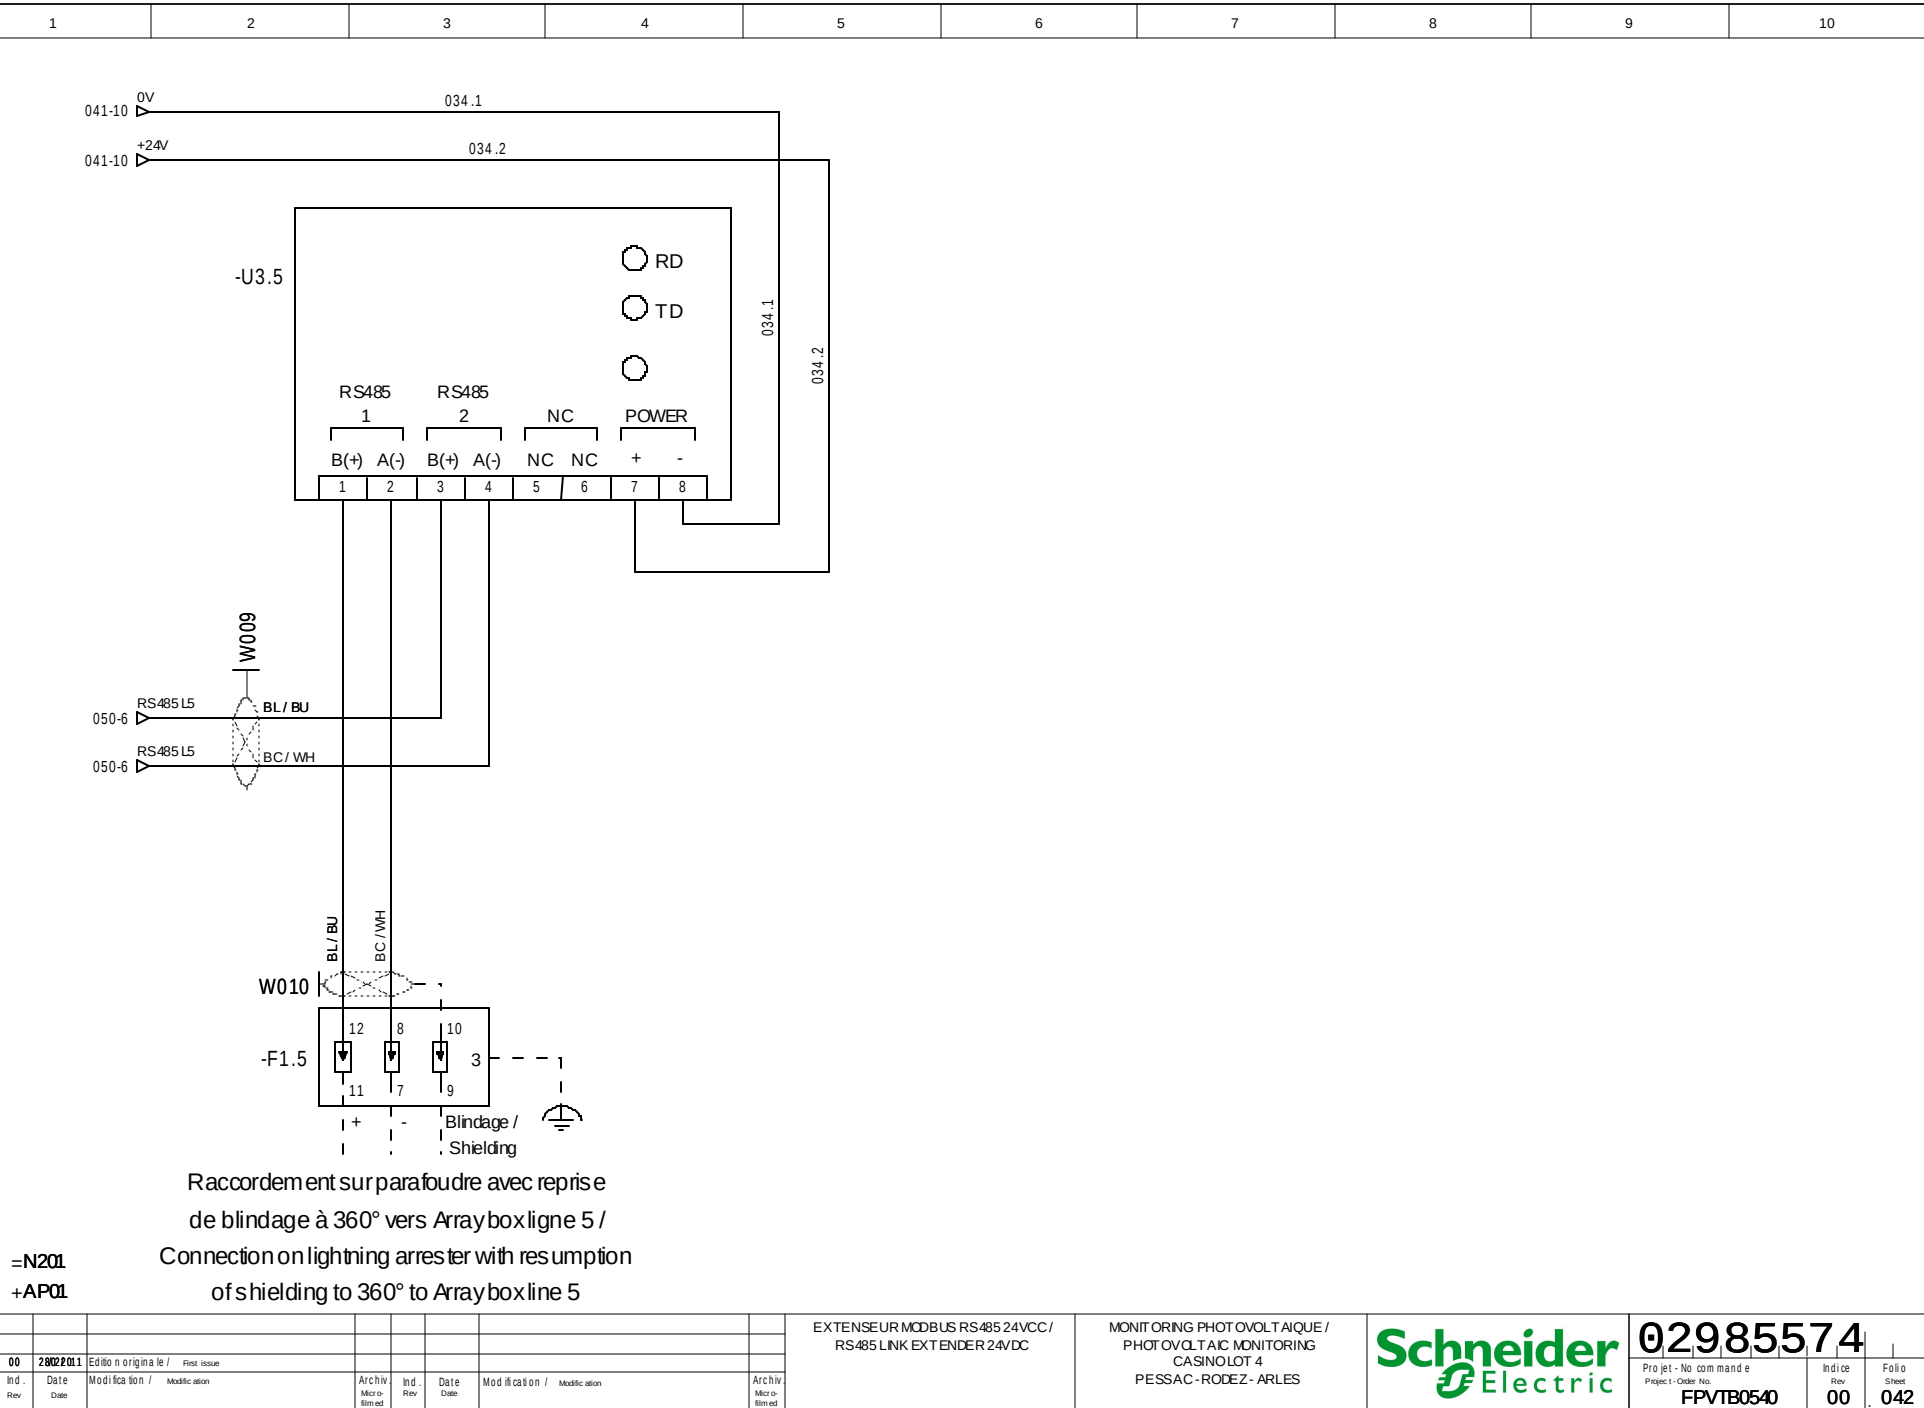

A

B

C

D

3

2

0




D


A3 suite - 01/2008

B

D

A3 suite - 01/2008

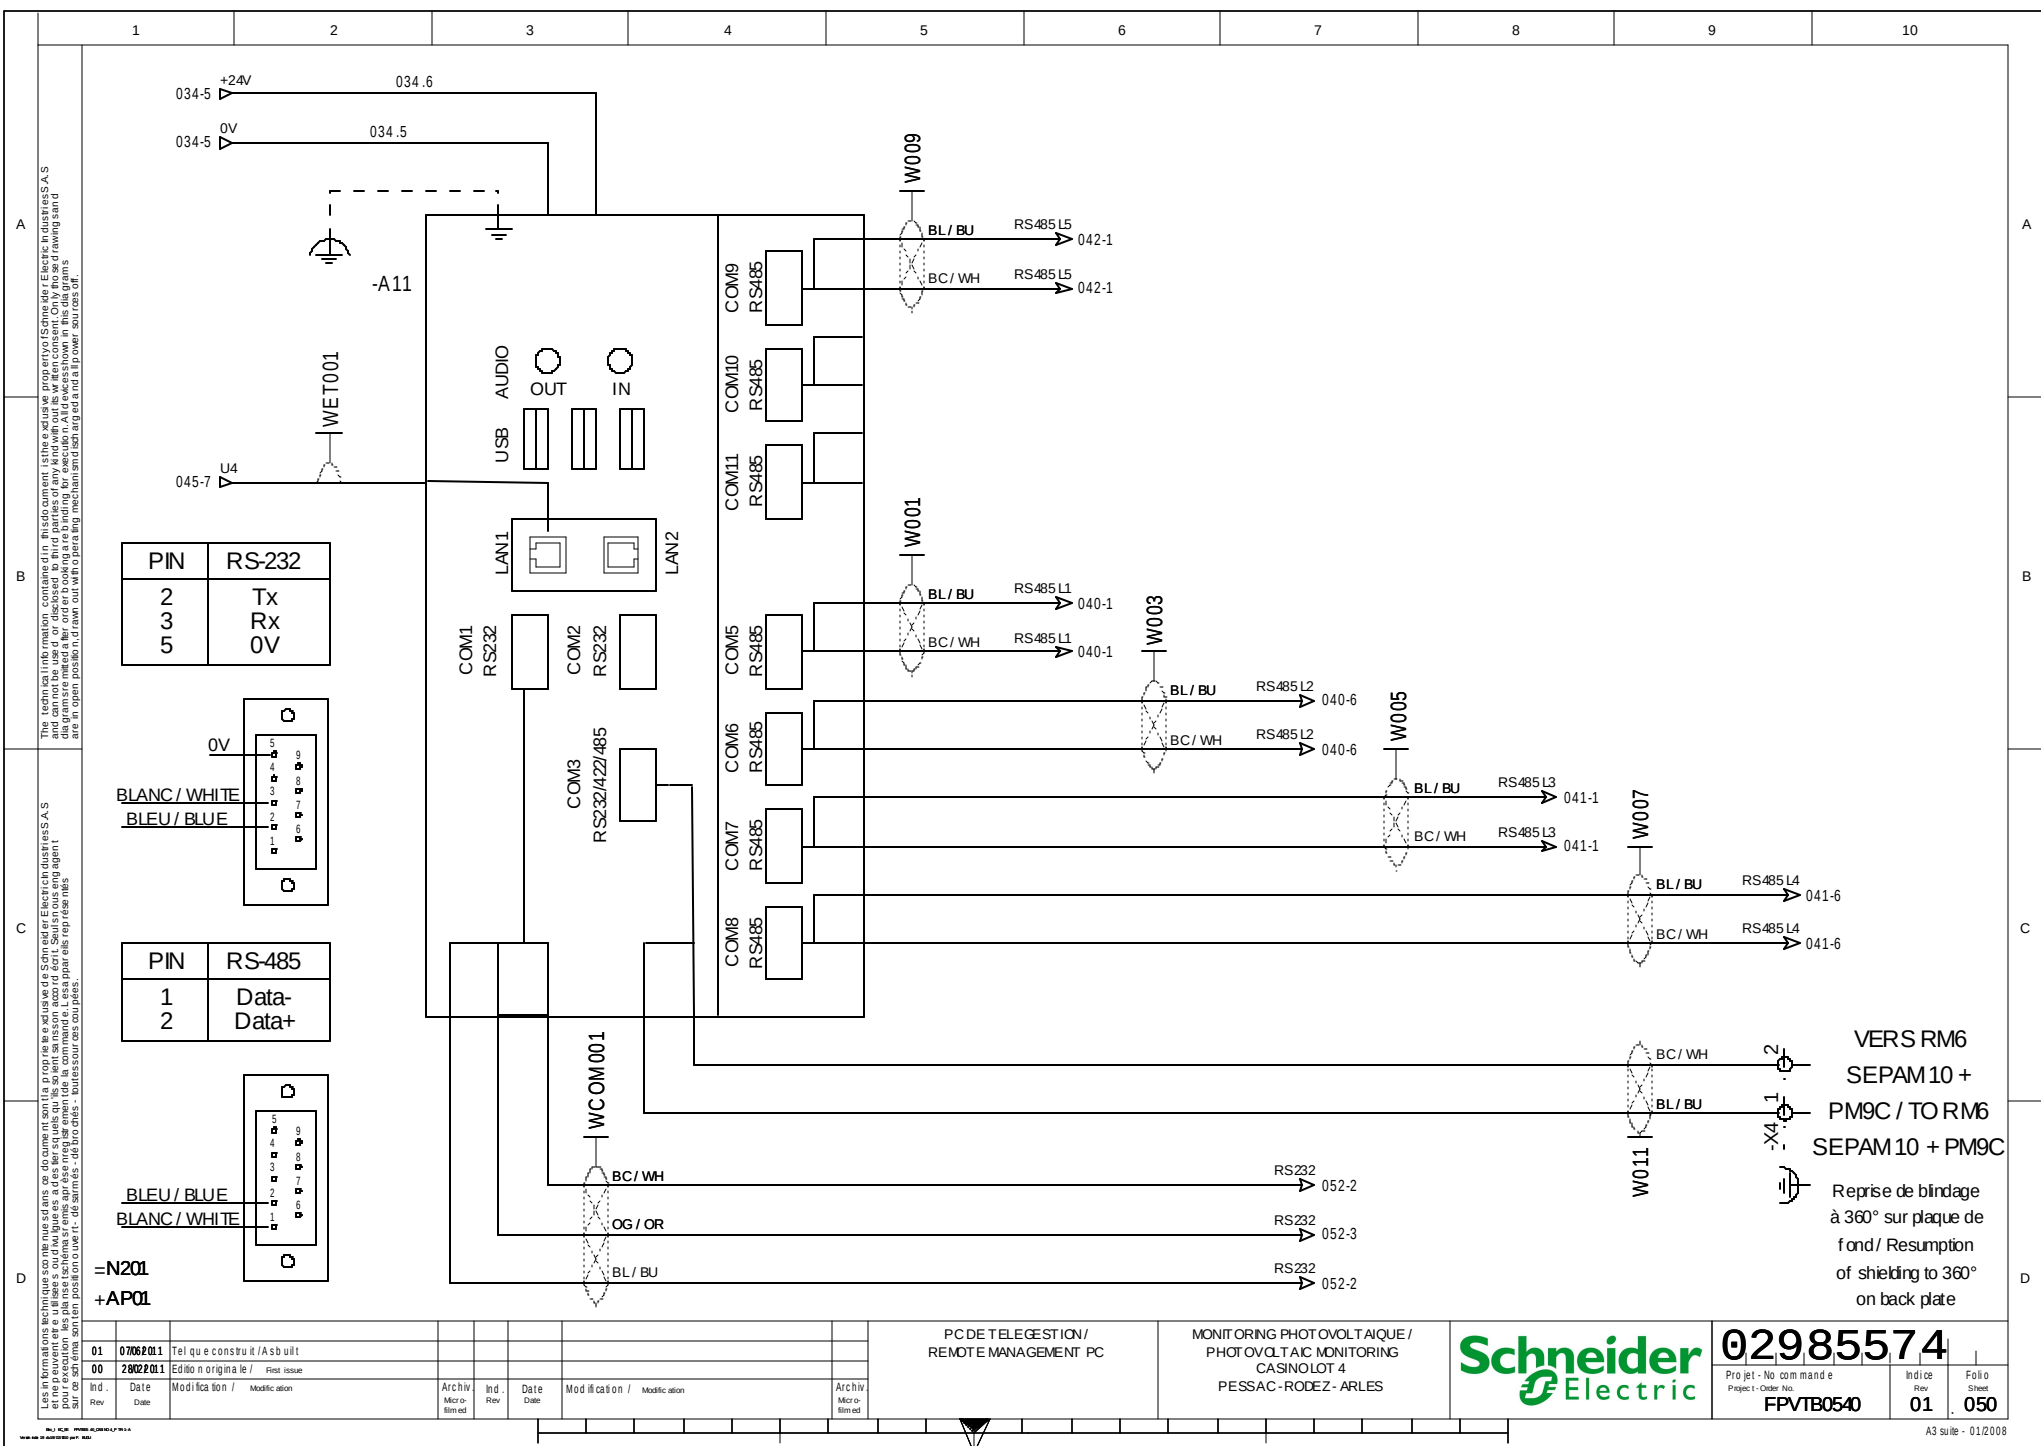

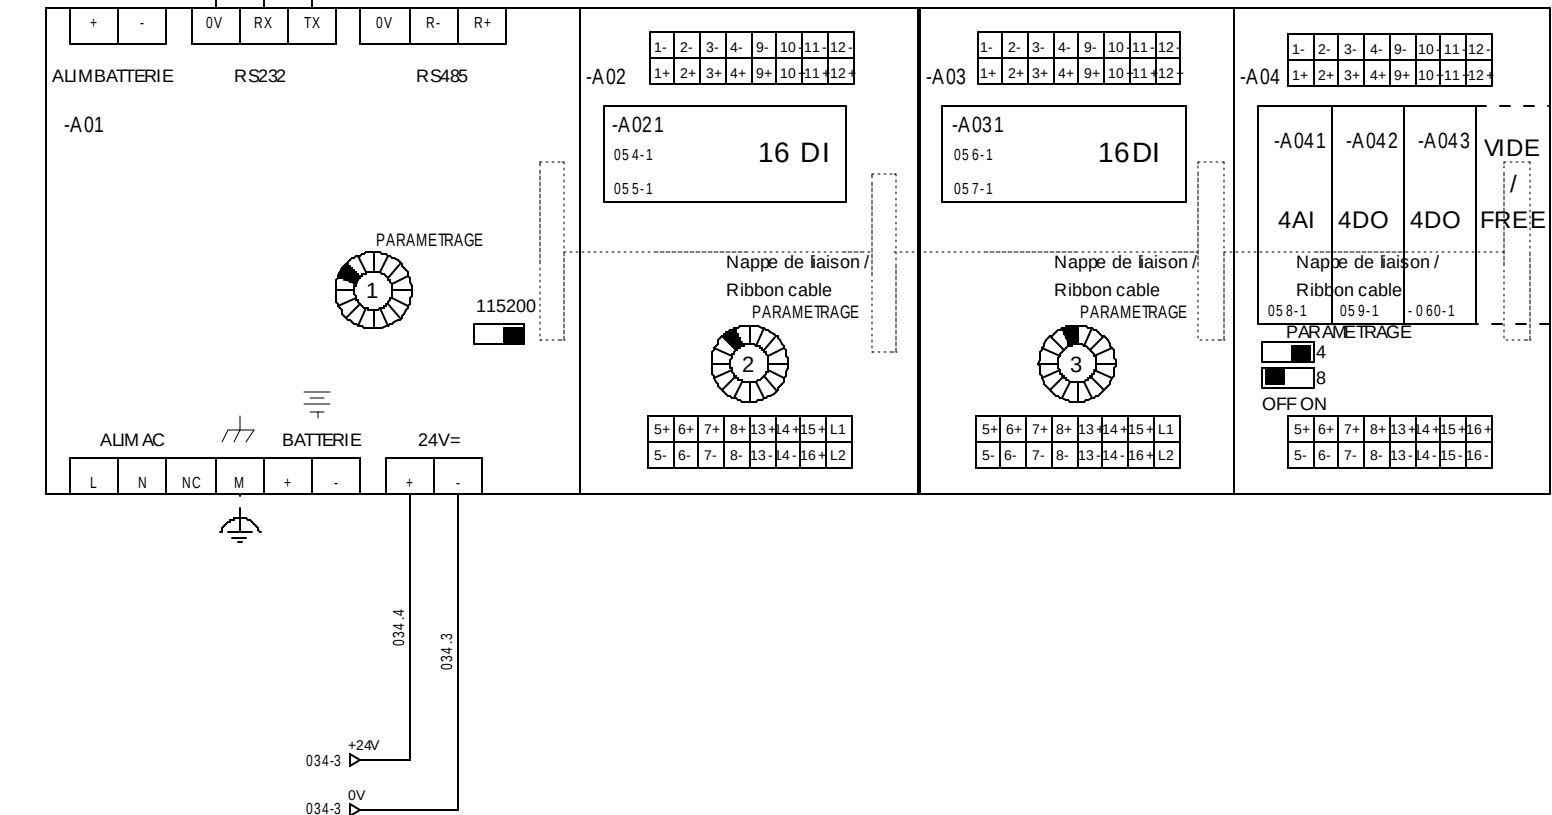

=N201
+AP01

01	07062011	Tel que e construit / As built							
00	28022011	Editio n originale / First issue							
Ind. / Rev.	Date	Modifica tion /	Modifica tion	Archiv Micro- filmé	Ind. / Rev.	Date	Modifica tion /	Modifica tion	Archiv Micro- filmé

APINAPAC / PLCNAPAC

MONITORING PHOTOVOLTAÏQUE /
PHOTOVOLTAÏC MONITORING
CASINO LOT 4
PESSAC - RODEZ - ARLES

Schneider
Electric

02985574									
Projet - No commande Project - Order No.							Indice Rev		
FPVTB0540							01		





CART 16 ENTREES TOR
ENTREES 1 A 8/
16 DIGITAL INPUTS BOARD
INPUTS 1 TO 8


MONITORING PHOTOVOLTAÏQUE /
PHOTOVOLTAÏC MONITORING
CASINOLOT 4
PESSAC - RODEZ - ARLES





02985574									
Projet - No commande							Indice		
Project - Order No.							Rev		
FPVTB0540							00		

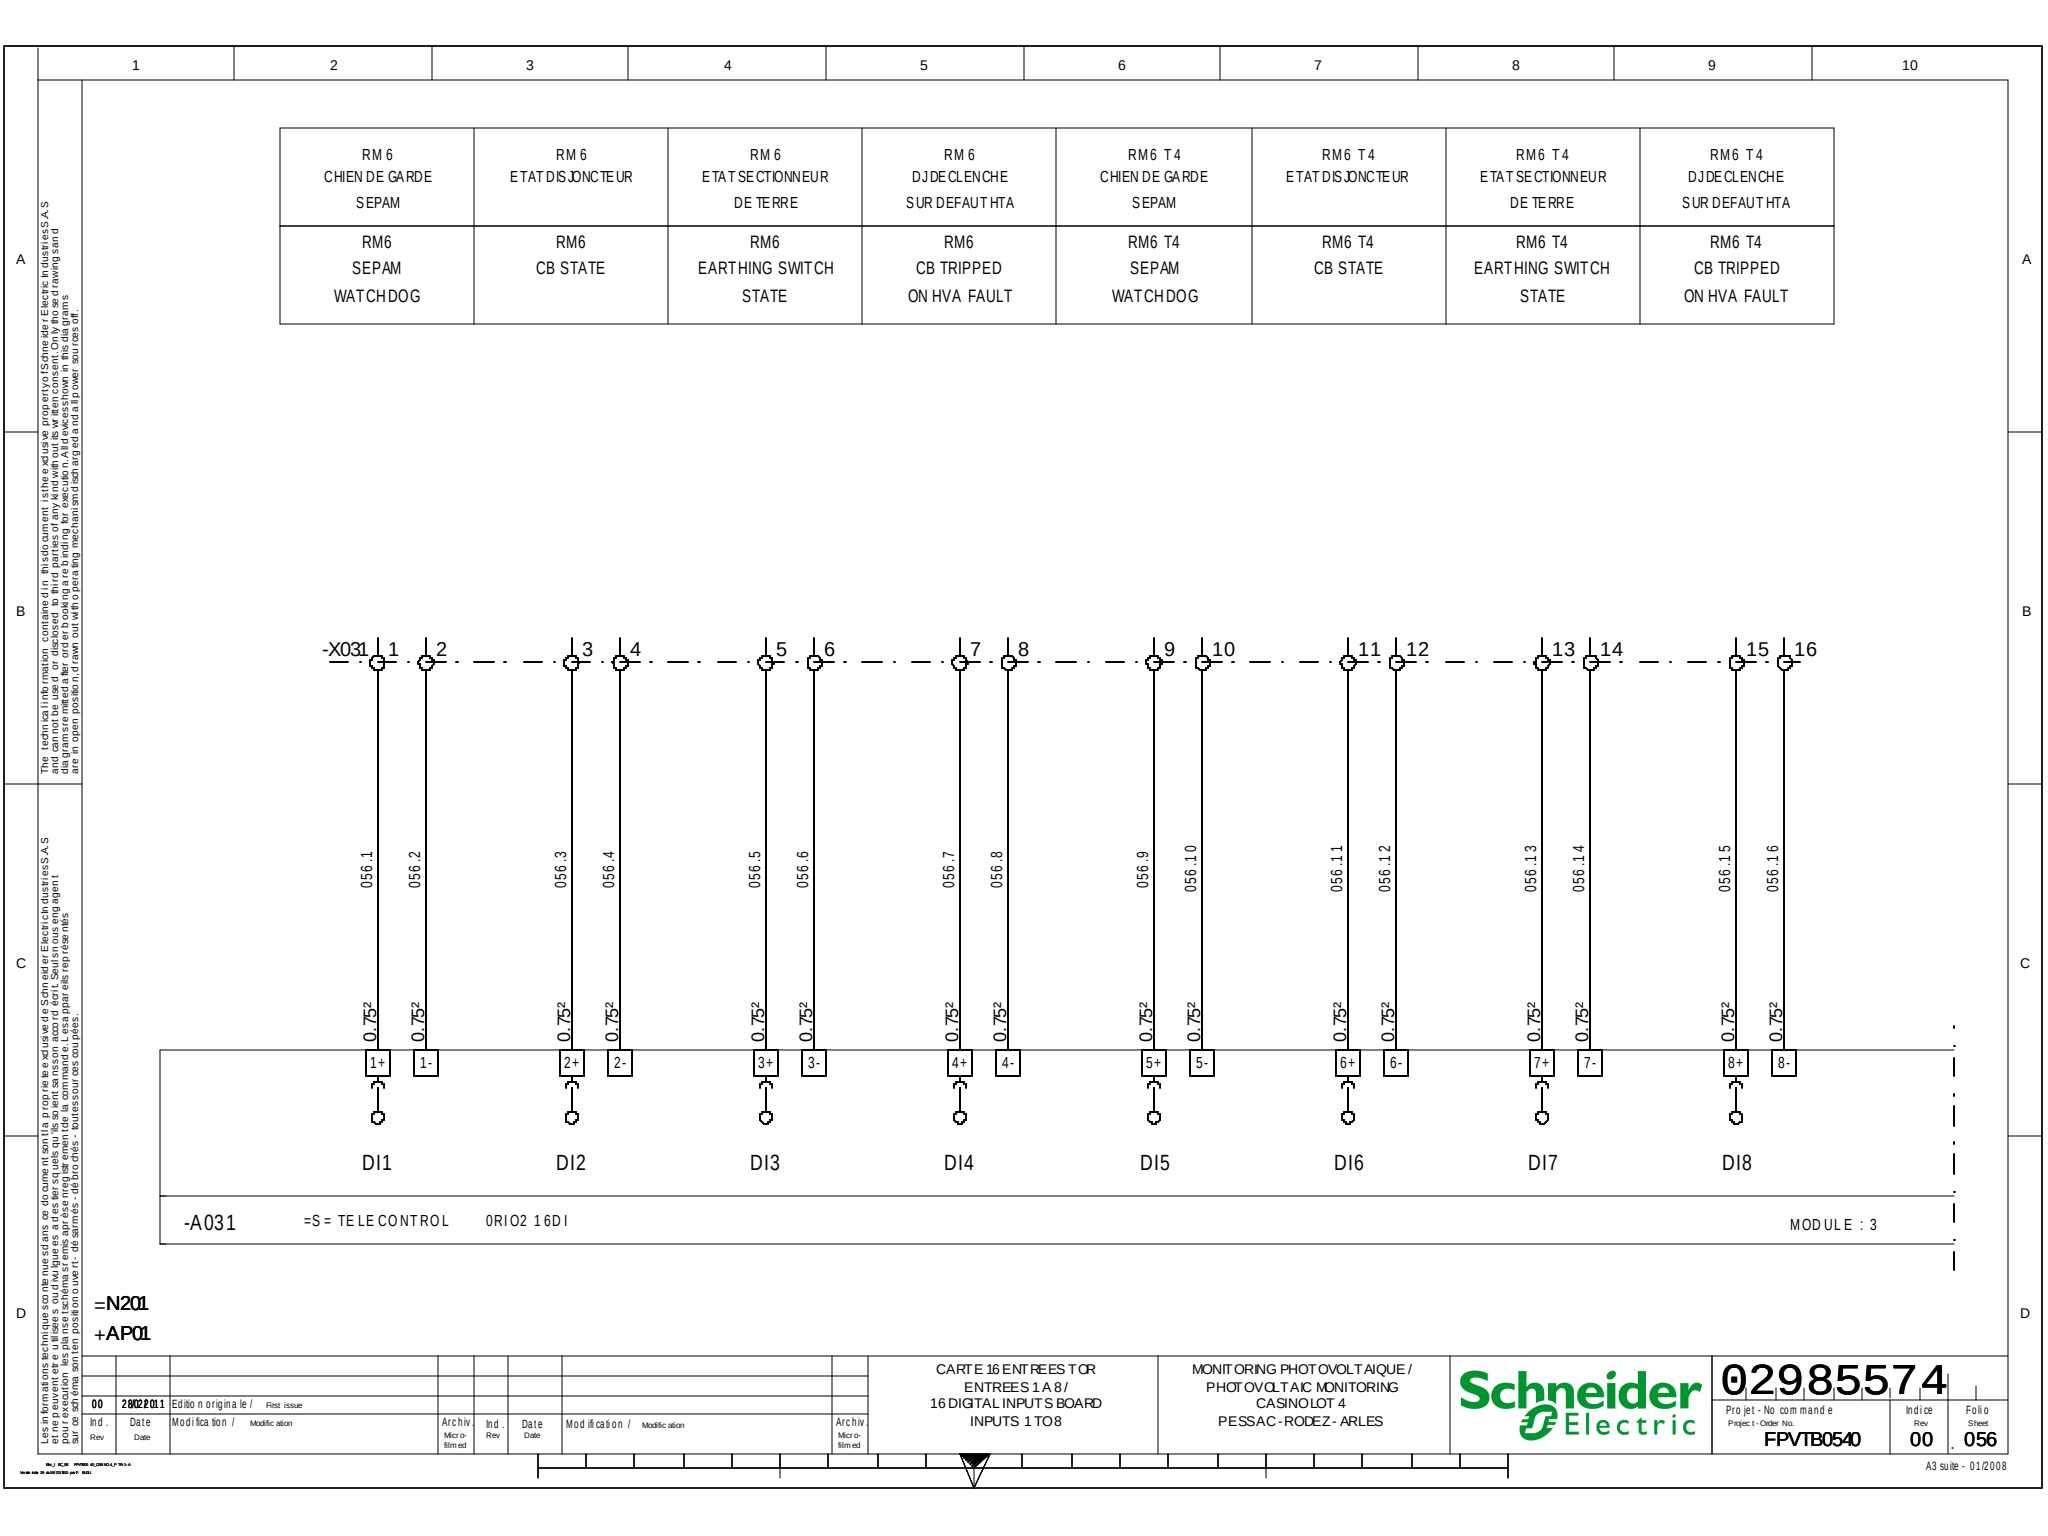

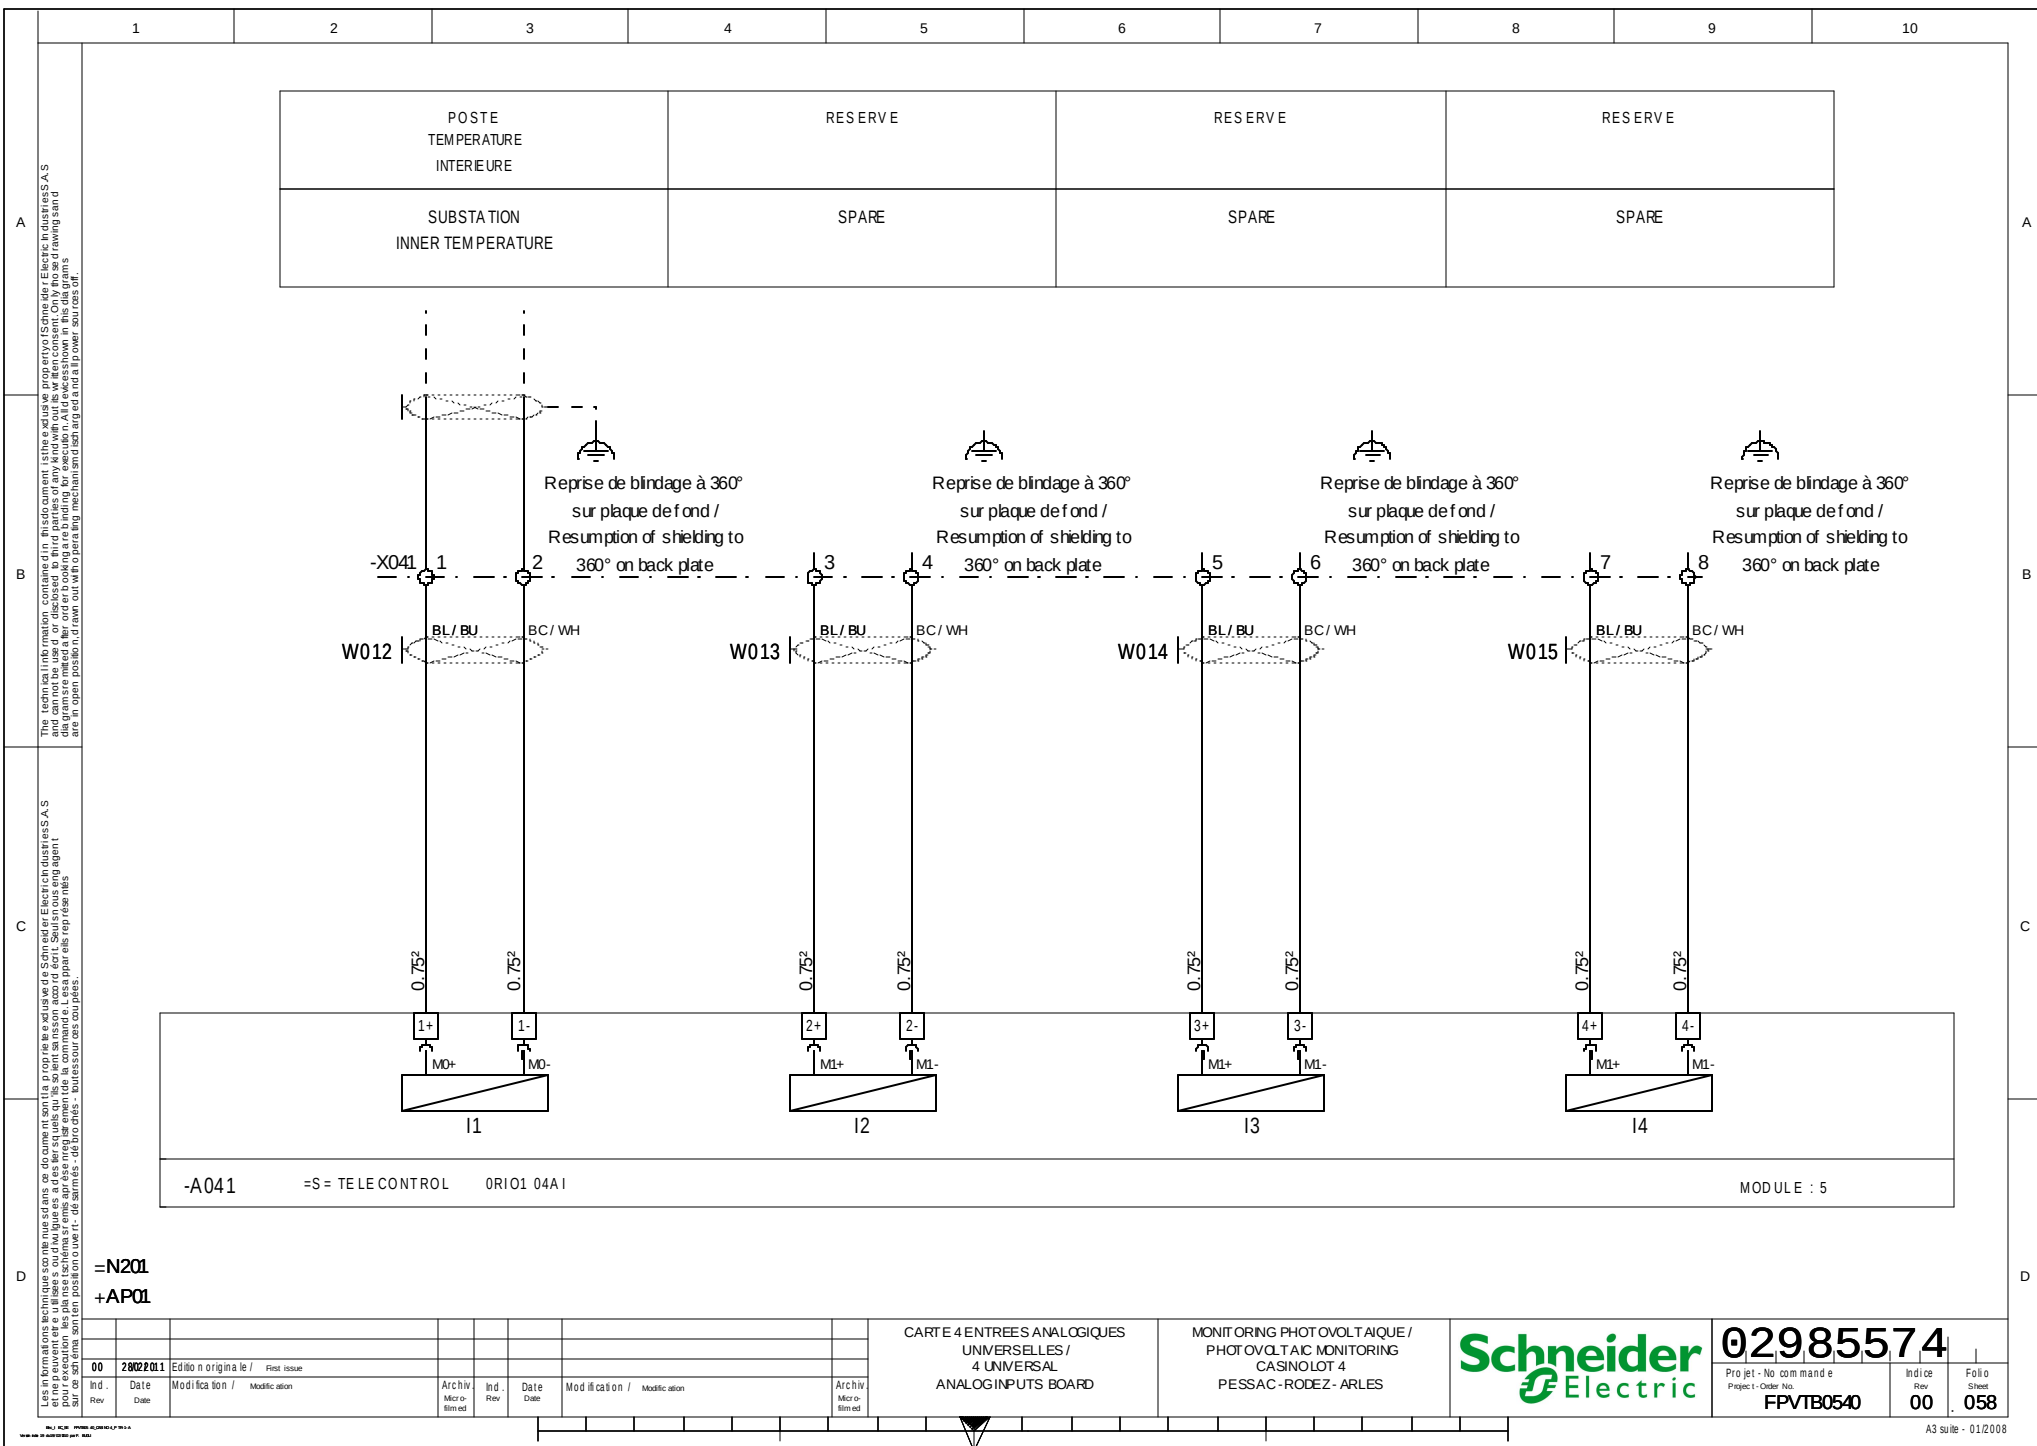

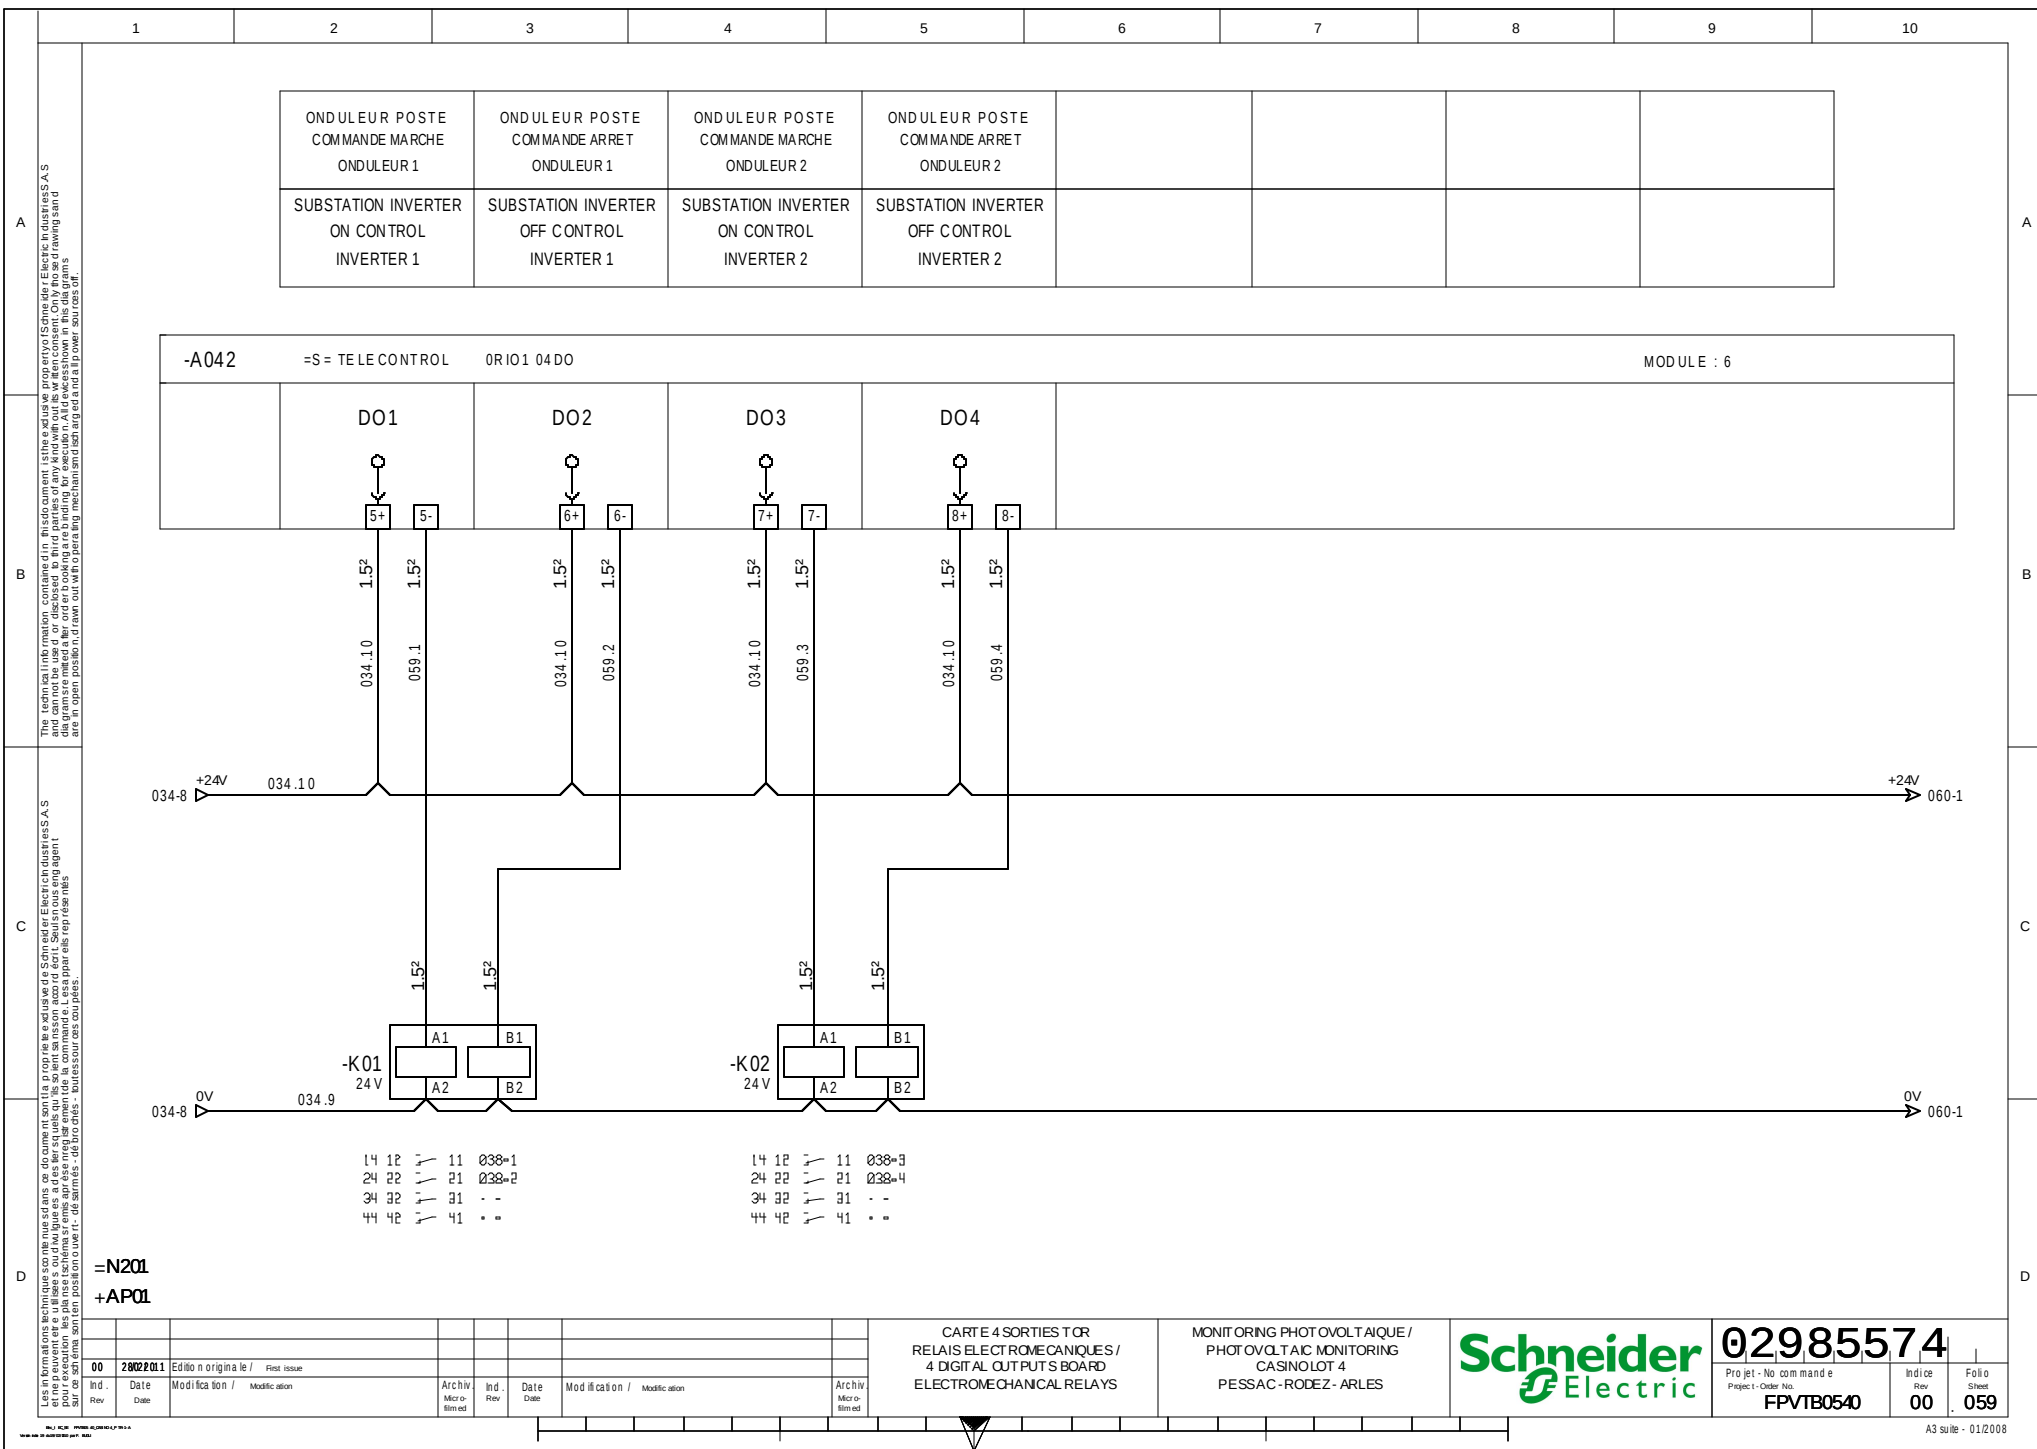

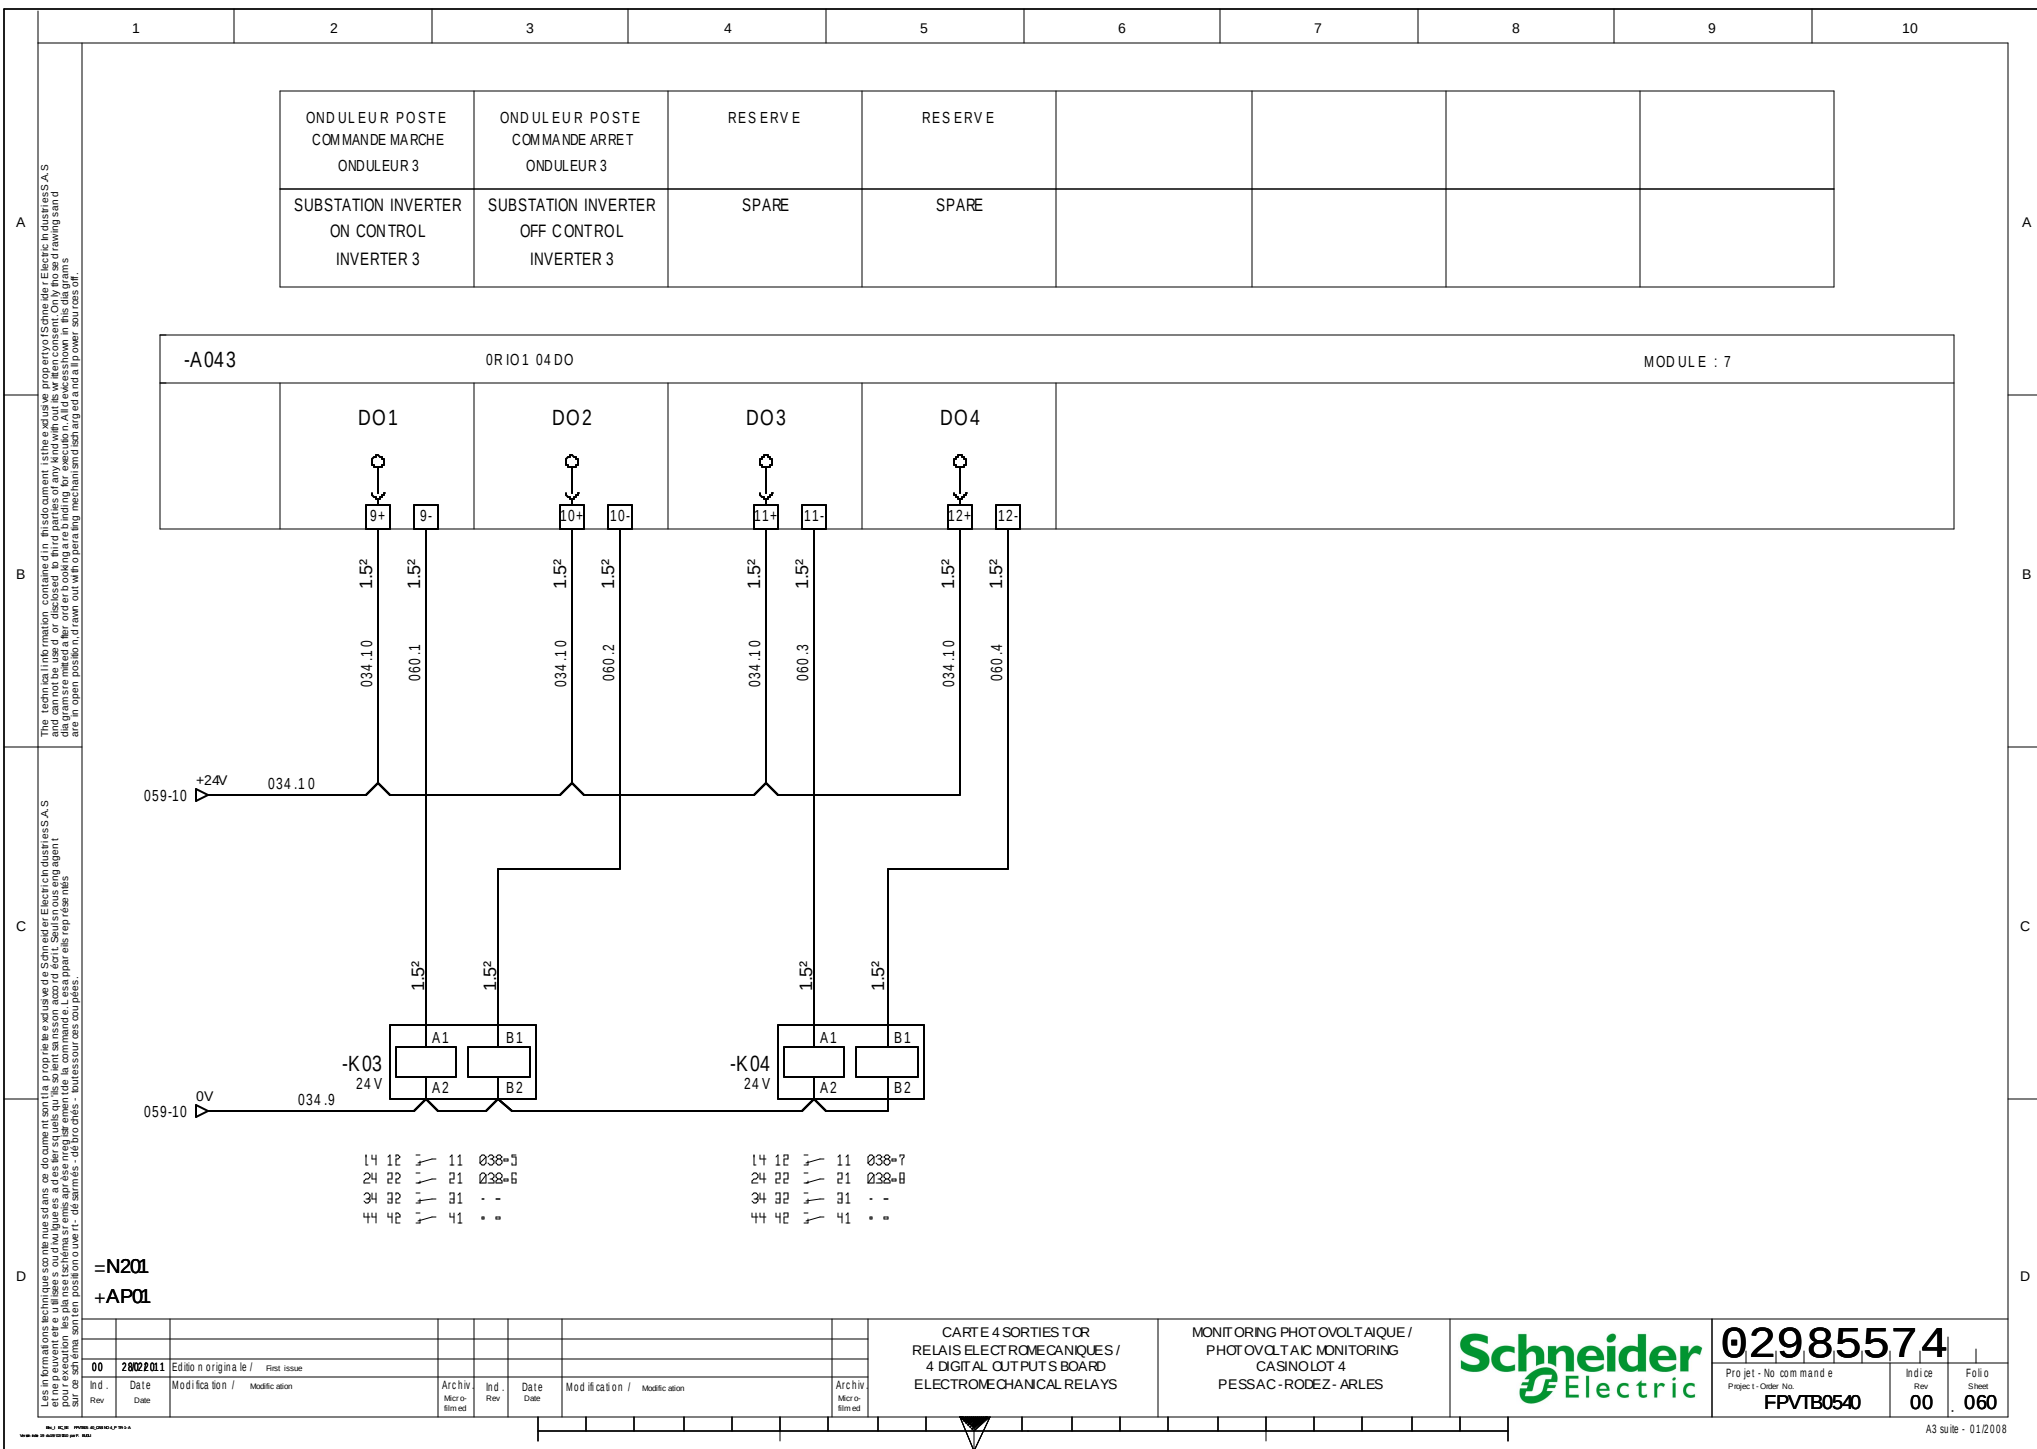

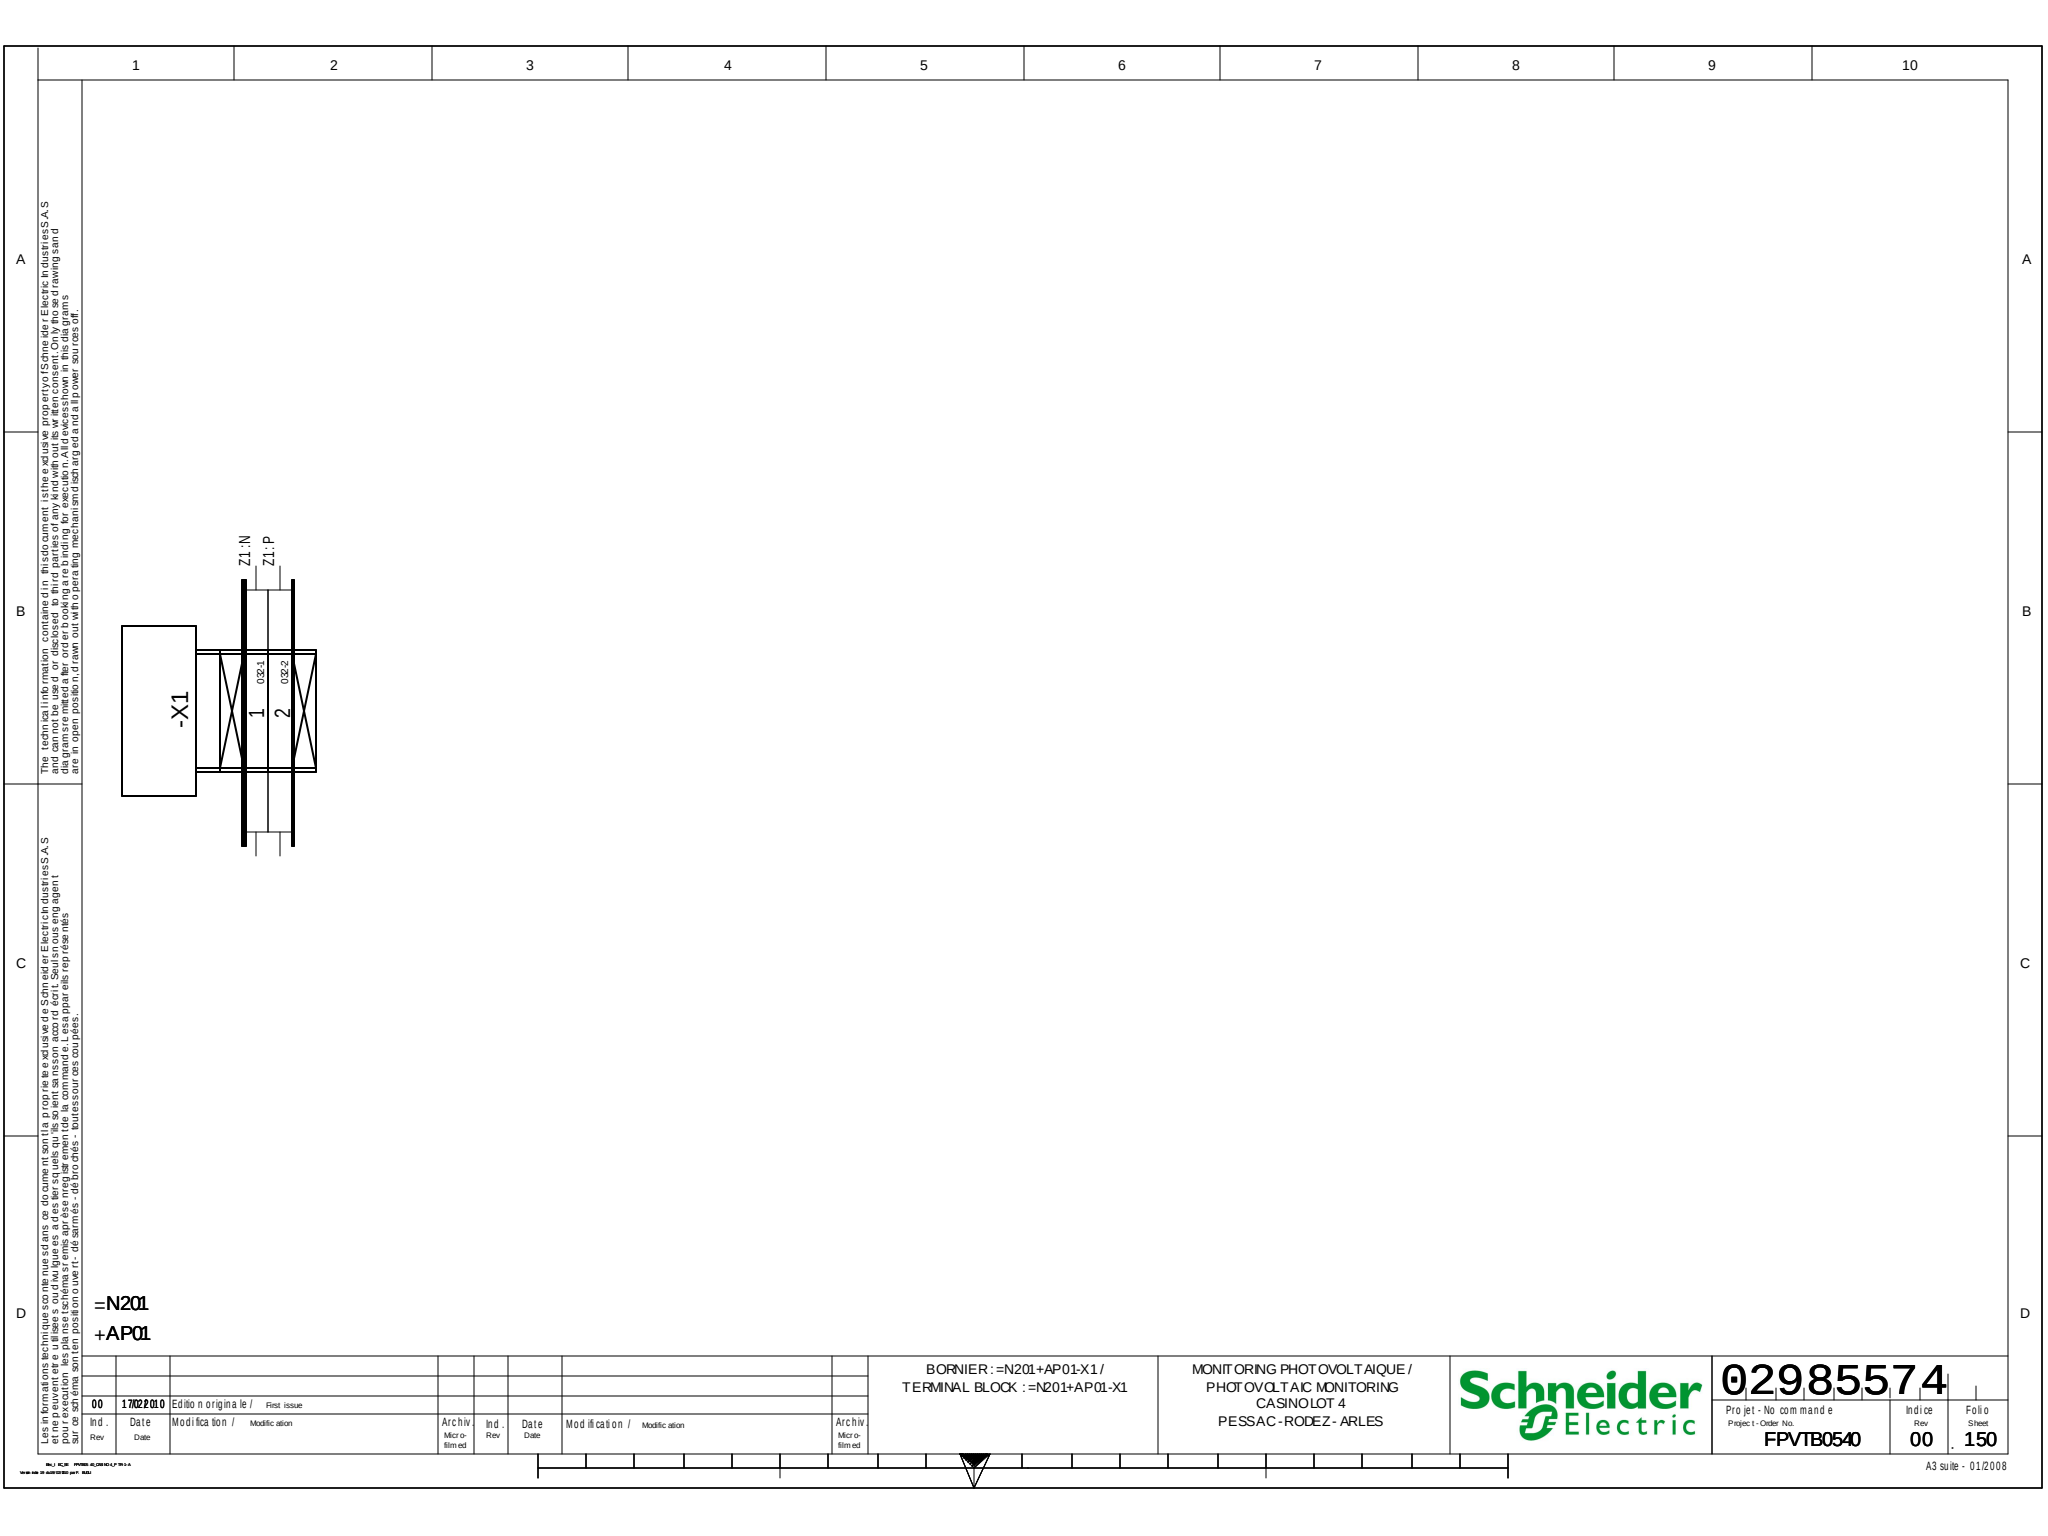

1		2		3	4	5	6	7	8	9	10	
Nom composant / Component name			Page Sheet	Designation						Fabricant Manufacturer	Ref. fabricant Manufacturer Ref.	
Localisation Location	Installation Function	Repère Tag										
A	AP01	N201	A01	052	ALIMENTATION BOITIER CPU PHENIX / CPU PHENIX POWER SUPPLY UNIT					=S= TELECONTROL	0RI02 UPS-2	
			A02	052	BOITIER EXT-2, 1 EMPLACEMENT CARTE T2 / EXT-2 UNIT, 1 T2 BOARD SLOT					=S= TELECONTROL	0RI02 EXT-2	
			A03	052	CARTE 4 SORTIES LOGIQUES RELAIS ELECTROMECHANIQUE, T1 / 4 ELECTROMECHANICAL RELAYS DIGITAL OUTPUTS BOARD, T1					=S= TELECONTROL	0RI01 04D0	
			A04	052	BOITIER EXT-1, 4 EMPLACEMENTS CARTES T1 / EXT-1 UNIT, 4 T1 BOARDS SLOTS					=S= TELECONTROL	0RI02 EXT-1	
			A11	050	PC DE TELEGESTION UNO-1170E AVEC CARTE EXT. RS485 / UNO-1170E REMOTE MANAGEMENT PC WITH RS485 EXPANSION PC					ADVANTECH	0ACC0000	
			A02I	052	CARTE 16 ENTREES LOGIQUES ET COMPTAGES, T2 / 16 SELF-POWERED DIGITAL AND COUNTING INPUTS BOARD, T2					=S= TELECONTROL	0RI02 16DI	
			A03I	052	CARTE 16 ENTREES LOGIQUES ET COMPTAGES, T2 / 16 SELF-POWERED DIGITAL AND COUNTING INPUTS BOARD, T2					=S= TELECONTROL	0RI02 16DI	
			A04I	052	CARTE 4 ENTREES ANALOGIQUES UNIVERSELLES, T1 / 4 UNIVERSAL ANALOG INPUTS BOARD, T1					=S= TELECONTROL	0RI01 04AI	
			A04Z	052	CARTE 4 SORTIES LOGIQUES RELAIS ELECTROMECHANIQUE, T1 / 4 ELECTROMECHANICAL RELAYS DIGITAL OUTPUTS BOARD, T1					=S= TELECONTROL	0RI01 04D0	
			A043	052	CARTE 4 SORTIES LOGIQUES RELAIS ELECTROMECHANIQUE, T1 / 4 ELECTROMECHANICAL RELAYS DIGITAL OUTPUTS BOARD, T1					=S= TELECONTROL	0RI01 04D0	
			F11	040	FICHE PARAFoudre HF 3 F-In10kA Ø(20)Jc:13VCC / HF LIGHTNING ARRESTER PLUG 3 W-In10kA Ø(20)Jc:13VDC					PHOENIX CONTACT	2858043	
				040	EMBASE PARAFoudre AVEC DECOUPLAGE ECRAN/MASSE / LIGHTNING ARRESTER SUPPORT WITH SHIELD/EXPOSED CONDUCTIVE PART					PHOENIX CONTACT	2856126	
				040	RACCORDEMENT AUTODENUDANT POUR BLINDAGE DIAMETRE 36mm / SELF-STRIPPER CONNECTION FOR SHIELD DIAMETER 36 mm					PHOENIX CONTACT	2839295	
			F12	040	FICHE PARAFoudre HF 3 F-In10kA Ø(20)Jc:13VCC / HF LIGHTNING ARRESTER PLUG 3 W-In10kA Ø(20)Jc:13VDC					PHOENIX CONTACT	2858043	
B				040	EMBASE PARAFoudre AVEC DECOUPLAGE ECRAN/MASSE / LIGHTNING ARRESTER SUPPORT WITH SHIELD/EXPOSED CONDUCTIVE PART					PHOENIX CONTACT	2856126	
				040	RACCORDEMENT AUTODENUDANT POUR BLINDAGE DIAMETRE 36mm / SELF-STRIPPER CONNECTION FOR SHIELD DIAMETER 36 mm					PHOENIX CONTACT	2839295	
				040	FICHE PARAFoudre HF 3 F-In10kA Ø(20)Jc:13VCC / HF LIGHTNING ARRESTER PLUG 3 W-In10kA Ø(20)Jc:13VDC					PHOENIX CONTACT	2858043	
				041	EMBASE PARAFoudre AVEC DECOUPLAGE ECRAN/MASSE / LIGHTNING ARRESTER SUPPORT WITH SHIELD/EXPOSED CONDUCTIVE PART					PHOENIX CONTACT	2856126	
				041	RACCORDEMENT AUTODENUDANT POUR BLINDAGE DIAMETRE 36mm / SELF-STRIPPER CONNECTION FOR SHIELD DIAMETER 36 mm					PHOENIX CONTACT	2839295	
			F14	041	FICHE PARAFoudre HF 3 F-In10kA Ø(20)Jc:13VCC / HF LIGHTNING ARRESTER PLUG 3 W-In10kA Ø(20)Jc:13VDC					PHOENIX CONTACT	2858043	
				041	EMBASE PARAFoudre AVEC DECOUPLAGE ECRAN/MASSE / LIGHTNING ARRESTER SUPPORT WITH SHIELD/EXPOSED CONDUCTIVE PART					PHOENIX CONTACT	2856126	
				041	RACCORDEMENT AUTODENUDANT POUR BLINDAGE DIAMETRE 36mm / SELF-STRIPPER CONNECTION FOR SHIELD DIAMETER 36 mm					PHOENIX CONTACT	2839295	
				042	FICHE PARAFoudre HF 3 F-In10kA Ø(20)Jc:13VCC / HF LIGHTNING ARRESTER PLUG 3 W-In10kA Ø(20)Jc:13VDC					PHOENIX CONTACT	2858043	
				042	EMBASE PARAFoudre AVEC DECOUPLAGE ECRAN/MASSE / LIGHTNING ARRESTER SUPPORT WITH SHIELD/EXPOSED CONDUCTIVE PART					PHOENIX CONTACT	2856126	
				042	RACCORDEMENT AUTODENUDANT POUR BLINDAGE DIAMETRE 36mm / SELF-STRIPPER CONNECTION FOR SHIELD DIAMETER 36 mm					PHOENIX CONTACT	2839295	
			K01	059	RELAIS BISTABLE AVEC DIODE 24VDC 4INV / LATCHING RELAY WITH SUPPRESSOR, 24 V DC, 40C					TELEMECANIQUE	RHK412BA76	
				059	EMBASE AVANT VIS / SCREW BASE PLATE					TELEMECANIQUE	RHZ21	
				059	ETRIER METALLIQUE DE MAINTIEN / METAL CLAMP					TELEMECANIQUE	RXZ400	
C			K02	059	RELAIS BISTABLE AVEC DIODE 24VDC 4INV / LATCHING RELAY WITH SUPPRESSOR, 24 V DC, 40C					TELEMECANIQUE	RHK412BA76	
				059	EMBASE AVANT VIS / SCREW BASE PLATE					TELEMECANIQUE	RHZ21	
				059	ETRIER METALLIQUE DE MAINTIEN / METAL CLAMP					TELEMECANIQUE	RXZ400	
			K03	060	RELAIS BISTABLE AVEC DIODE 24VDC 4INV / LATCHING RELAY WITH SUPPRESSOR, 24 V DC, 40C					TELEMECANIQUE	RHK412BA76	
				060	EMBASE AVANT VIS / SCREW BASE PLATE					TELEMECANIQUE	RHZ21	
				060	ETRIER METALLIQUE DE MAINTIEN / METAL CLAMP					TELEMECANIQUE	RXZ400	
			K04	060	RELAIS BISTABLE AVEC DIODE 24VDC 4INV / LATCHING RELAY WITH SUPPRESSOR, 24 V DC, 40C					TELEMECANIQUE	RHK412BA76	
				060	EMBASE AVANT VIS / SCREW BASE PLATE					TELEMECANIQUE	RHZ21	
				060	ETRIER METALLIQUE DE MAINTIEN / METAL CLAMP					TELEMECANIQUE	RXZ400	
			QF1	032	INTER IBI 20A SANS VOYANT / SWITCH-DISCONNECTOR I 2P, 20 A					MERLINGERN	15006	
			QF2	034	DISJONCTEUR C60H-DC BI 1 A COURBE C / MINIATURE CIRCUIT BREAKER MULTI9, C60H-DC, 2 POLES, 2 A, C CURVE					MERLINGERN	MGN61521	
				034	CONTACT OF+SD/OF / AUXILIARY CONTACT, 1 OC + 1 SD/OC					MERLINGERN	26929	
			QF4	034	DISJONCTEUR C60H-DC BI 1 A COURBE C / MINIATURE CIRCUIT BREAKER MULTI9, C60H-DC, 2 POLES, 2 A, C CURVE					MERLINGERN	MGN61521	
				034	CONTACT OF+SD/OF / AUXILIARY CONTACT, 1 OC + 1 SD/OC					MERLINGERN	26929	
D			QF5	034	DISJONCTEUR C60H-DC BI 1 A COURBE C / MINIATURE CIRCUIT BREAKER MULTI9, C60H-DC, 2 POLES, 2 A, C CURVE					MERLINGERN	MGN61521	
				034	CONTACT OF+SD/OF / AUXILIARY CONTACT, 1 OC + 1 SD/OC					MERLINGERN	26929	
			QF6	034	DISJONCTEUR C60H-DC BI 1 A COURBE C / MINIATURE CIRCUIT BREAKER MULTI9, C60H-DC, 2 POLES, 2 A, C CURVE					MERLINGERN	MGN61521	
			QF7	035	DISJONCTEUR C60H-DC BI 2 A COURBE C / MINIATURE CIRCUIT BREAKER MULTI9, C60H-DC, 2 POLES, 2 A, C CURVE					MERLINGERN	MGN61522	
				035	CONTACT OF+SD/OF / AUXILIARY CONTACT, 1 OC + 1 SD/OC					MERLINGERN	26929	
			N201	QF8	035	DISJONCTEUR C60H-DC BI 1 A COURBE C / MINIATURE CIRCUIT BREAKER MULTI9, C60H-DC, 2 POLES, 2 A, C CURVE					MERLINGERN	MGN61521
			AP01	QF31	034	DISJONCTEUR C60H-DC BI 1 A COURBE C / MINIATURE CIRCUIT BREAKER MULTI9, C60H-DC, 2 POLES, 2 A, C CURVE					MERLINGERN	MGN61521
				QF32	034	DISJONCTEUR C60H-DC BI 2 A COURBE C / MINIATURE CIRCUIT BREAKER MULTI9, C60H-DC, 2 POLES, 2 A, C CURVE					MERLINGERN	MGN61522
NOMENCLATURE / PART LIST												
MONITORING PHOTOVOLTAIQUE / PHOTOVOLTAGE MONITORING CASINOLOT 4 PESSAC-RODEZ-ARLES												
Schneider Electric												
02985574												
Projet - No de commande FPVTB0540												
Indice Rev 00												
Folio Sheet 200												

□